

New Location   
 Deeper   
 Abandonment

✓ JUN 21 1946

Company Smith, Pierson, Feick & Co.  
 Address Walker, R.F. No. 2 WVA.  
 Farm L.N. & E.B. Fetty  
 Tract 1 Acres 61/2 Lease No. \_\_\_\_\_  
 Well (Farm) No. 3 Serial No. \_\_\_\_\_  
 Elevation (Spirit Level) 870'  
 Quadrangle WEST UNION  
 County TYLER District MEADE  
 Engineer J.E. Anderson, Wood Co.  
 Engineer's Registration No. SURVEYOR  
 File No. \_\_\_\_\_ Drawing No. \_\_\_\_\_  
 Date June 14<sup>th</sup> 1946 Scale 1 in = 200 = 330'

STATE OF WEST VIRGINIA  
 DEPARTMENT OF MINES  
 OIL AND GAS DIVISION  
 CHARLESTON

WELL LOCATION MAP  
 FILE NO. TYL-396-A

+ Denotes location of well on United States Topographic Maps, scale 1 to 62,500, latitude and longitude lines being represented by border lines as shown.  
 - Denotes one inch spaces on border line of original tracing.

STATE OF WEST VIRGINIA  
DEPARTMENT OF MINES  
OIL AND GAS DIVISION

390

WELL RECORD

Oil or Gas Well **oil**  
(KIND)


Permit No. **none**

Company **Smith, Pierson, Peick & Coss**  
 Address **Walker, F.F.D. No. 2, 2, VA.**  
 Farm **L.H. & E.B. Petty** Acres **51 - 51/160**  
 Location (waters) **Sugar Creek**  
 Well No. **3** Elev. **870**  
 District **Head** County **Tyler**  
 The surface of tract is owned in fee by **L.H. & E.B. Petty**  
 Address **Vienna, VA.**  
 Mineral rights are owned by **same**  
 Address \_\_\_\_\_  
 Drilling completed \_\_\_\_\_  
 Date Shot **10-20-08** From \_\_\_\_\_ To \_\_\_\_\_  
 With **20 quarts**  
 Open Flow /10ths Water in \_\_\_\_\_ Inch  
 /10ths Merc. in \_\_\_\_\_ Inch  
 Volume \_\_\_\_\_ Cu. Ft.  
 Rock Pressure \_\_\_\_\_ lbs. \_\_\_\_\_ hrs.  
 Oil \_\_\_\_\_ bbls., 1st 24 hrs.  
 Fresh water \_\_\_\_\_ feet \_\_\_\_\_ feet  
 Salt water \_\_\_\_\_ feet \_\_\_\_\_ feet

Casing and Tubing	Used in Drilling	Left in Well	Packers
16. _____			Kind of Packer _____
13. _____			
10. _____	<b>250</b>	<b>000</b>	Size of _____
8 1/4. _____	<b>1060</b>	<b>0900</b>	
6 5/8. _____	<b>1590</b>	<b>1590</b>	Depth set _____
5 3/16. _____	<b>1709</b>	<b>1709</b>	
3. _____			Perf. top _____
2. _____	<b>1800</b>	<b>1800</b>	Perf. bottom _____
Liners Used _____			Perf. top _____
			Perf. bottom _____

CASING CEMENTED \_\_\_\_\_ SIZE \_\_\_\_\_ No. Ft. \_\_\_\_\_ Date \_\_\_\_\_  
 COAL WAS ENCOUNTERED AT **Pittsburgh** **300** FEET **60** INCHES  
 \_\_\_\_\_ FEET \_\_\_\_\_ INCHES FEET \_\_\_\_\_ INCHES  
 \_\_\_\_\_ FEET \_\_\_\_\_ INCHES FEET \_\_\_\_\_ INCHES

Formation	Color	Hard or Soft	Top	Bottom	Oil, Gas or Water	Depth Found	Remarks
The following record was furnished us by the South Penn Natural Gas Company from whom we purchased this well:							
Pittsburgh Coal			300	305			
Red Rock			690	890			
1st Cow Run Sand			890	900			
1st Salt Sand			1150	1200			
2nd Salt Sand			1300	1465			
Maxon			1655	1675			
Big Lime			1700	1770			
Keener			1700	1792			
Big Injun			1804	1866			
Gas			1821				
Oil			1828	1864			
Total Depth				1866			

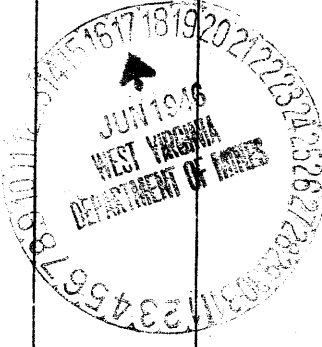

Formation	Color	Hard or Soft	Top	Bottom	Oil, Gas or Water	Depth Found	Remarks

Date 6 15, 1946

APPROVED Smith Pierso Feick & Co., Owner

By E. P. Pierso  
(Title)