

New Location  
 Drill Deeper  
 Abandonment

OCT - 7 1946

Company Smith, Piersol, Feick & Coss  
 Address R.F.D. No. Walker, WVA.  
 Farm Garnet C. Fletcher Formerly J.L. Poe  
 Tract \_\_\_\_\_ Acres 26 3/4 Lease No. \_\_\_\_\_  
 Well (Farm) No. 11 Serial No. \_\_\_\_\_  
 Elevation (Spirit Level) 985'  
 Quadrangle WEST UNION  
 County TYLER District MEADE  
 Engineer J.E. Anderson, Wood Co.  
 Engineer's Registration No. Surveyor  
 File No. \_\_\_\_\_ Drawing No. \_\_\_\_\_  
 Date June 10 1946 Scale 1 in = 20 P = 330'

STATE OF WEST VIRGINIA  
 DEPARTMENT OF MINES  
 OIL AND GAS DIVISION  
 CHARLESTON

WELL LOCATION MAP  
 FILE NO. TYL-404-A

+ Denotes location of well on United States Topographic Maps, scale 1 to 62,500, latitude and longitude lines being represented by border lines as shown.  
 - Denotes one inch spaces on border line of original tracing.

STATE OF WEST VIRGINIA  
DEPARTMENT OF MINES  
OIL AND GAS DIVISION

394

WELL RECORD

Permit No. 104-A Oil or Gas Well (KIND)


Company Smith, Pierson, Feick & Coss  
 Address Walker R. #2, W. VA.  
 Farm J. L. Poe Acres 26 3/4  
 Location (waters) Mekin Creek  
 Well No. 11 Elev. 980  
 District Head County Tyler  
 The surface of tract is owned in fee by G. C. Fletcher  
 Address Parkersburg, W. VA.  
 Mineral rights are owned by G. C. Fletcher  
 Address Head  
 Drilling commenced January 1902  
 Drilling completed January 1902  
 Date Shot From To  
 With no record  
 Open Flow /10ths Water in no record Inch  
 /10ths Merc. in Inch  
 Volume Cu. Ft.  
 Rock Pressure lbs hrs.  
 Oil bbls., 1st 24 hrs.  
 Fresh water feet feet  
 Salt water feet feet

Casing and Tubing	Used in Drilling	Left in Well	Packers
Size			Kind of Packer
16.			
13.			
10.	640	640	Size of
8 1/4	1420	1420	
6 1/4	1868	1868	Depth set
5 3/16			
3.			Perf. top
2.			Perf. bottom
Liners Used			Perf. top
			Perf. bottom

CASING CEMENTED SIZE No. Ft. Date  
 COAL WAS ENCOUNTERED AT FEET INCHES  
 FEET INCHES FEET INCHES  
 FEET INCHES FEET INCHES

Formation	Color	Hard or Soft	Top	Bottom	Oil, Gas or Water	Depth Found	Remarks
Pittsburgh Coal			620	623			
Red Rock			800	1100			
1st Cow Run Sand			1200	1215			
1st Salt Sand			1400	1700			
Maxon			1920	1950			
Big Lime			2000	2085			
Injun			2121	2138			
Gas			2138				
Oil			2138				
Total Depth				2138			

This record was furnished by South Penn Natural Gas Co. from whom we purchased the well

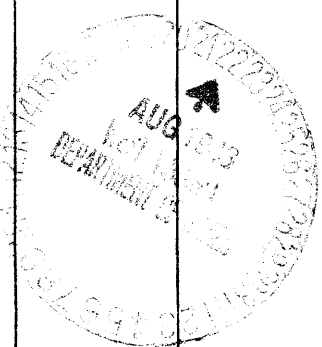

Formation	Color	Hard or Soft	Top	Bottom	Oil, Gas or Water	Depth Found	Remarks

Date August 3, 1946, 194

APPROVED Smith, Pierson, Peiron & Coss, Owner

By E. P. Pierson  
(Title)