


⊕  
2.58 W  
0.91 S

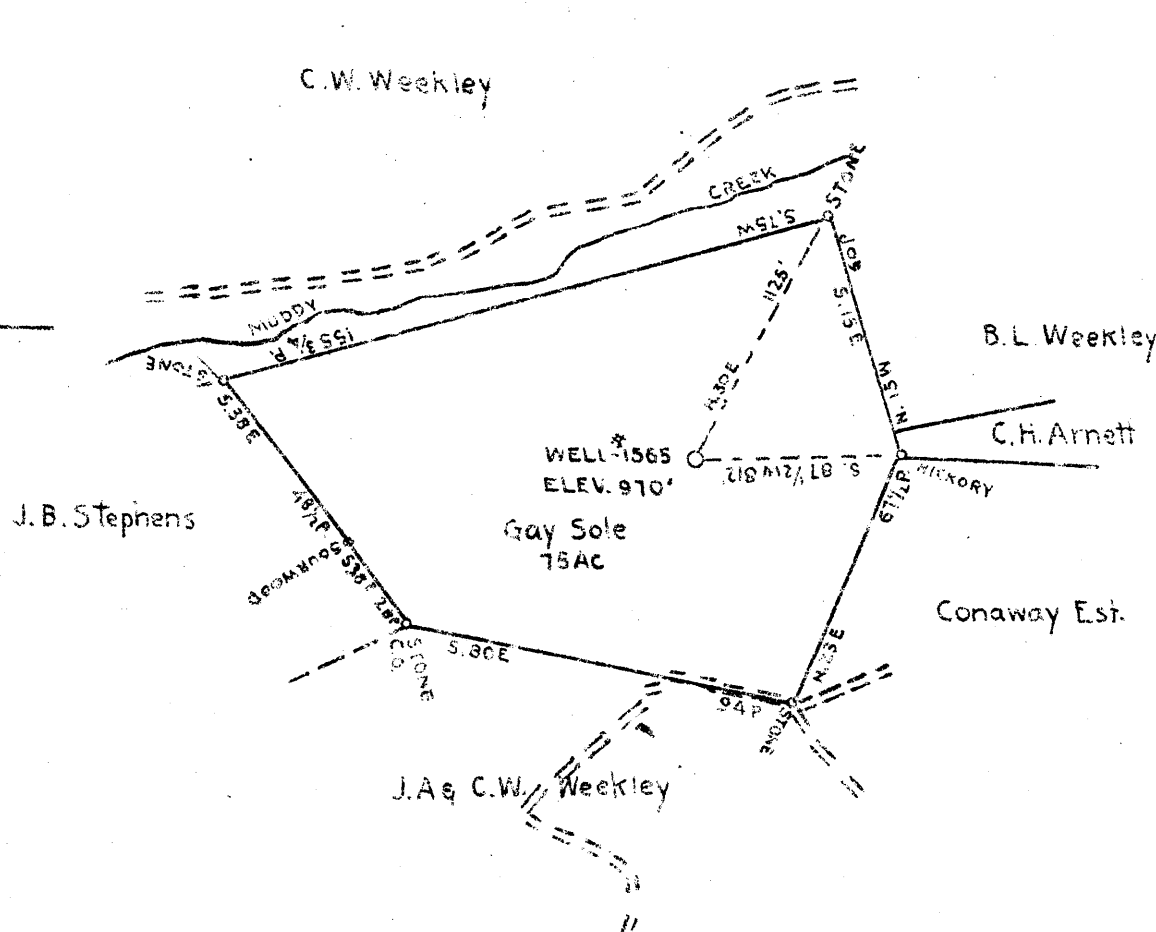

2.16 W  
0.91 S

COAL OWNED BY... Gay Sole Middlebourne W.Va.

NEW LOCATION

DRILL DEEPER

ABANDONMENT

✓ OCT - 9 1946

COMPANY The Manufacturers Light and Heat Company

ADDRESS 800 Union Trust Building, Pittsburgh Pa.

FARM Gay Sole

TRACT ACRES 75 LEASE NO. 4270

WELL (FARM) NO. 1 SERIAL N 1565

ELEVATION (SPIRIT LEVEL) 910

QUADRANGLE West Union

COUNTY Tyler DISTRICT Ellsworth

ENGINEER J. L. ...

ENGINEER'S REGISTRATION NO.

FILE NO. DRAWING NO. YW-218

DATE September 16 1946 SCALE 1" = 800'

STATE OF WEST VIRGINIA  
 DEPARTMENT OF MINES  
 OIL AND GAS DIVISION  
 CHARLESTON

WELL LOCATION MAP

FILE NO. TYL-405-A

⊕ DENOTES LOCATION OF WELL ON UNITED STATES TOPOGRAPHIC MAPS SCALE 1 TO 62 500. LATITUDE AND LONGITUDE LINES BEING REPRESENTED BY BORDER LINES AS SHOWN.

--- DENOTES ONE INCH SPACES ON BORDER LINE OF ORIGINAL TRACING