


0.39 W
1.36 S

0.44 W
1.44 S

0.30 W
1.43 S

J. Sellers

Longitude 78

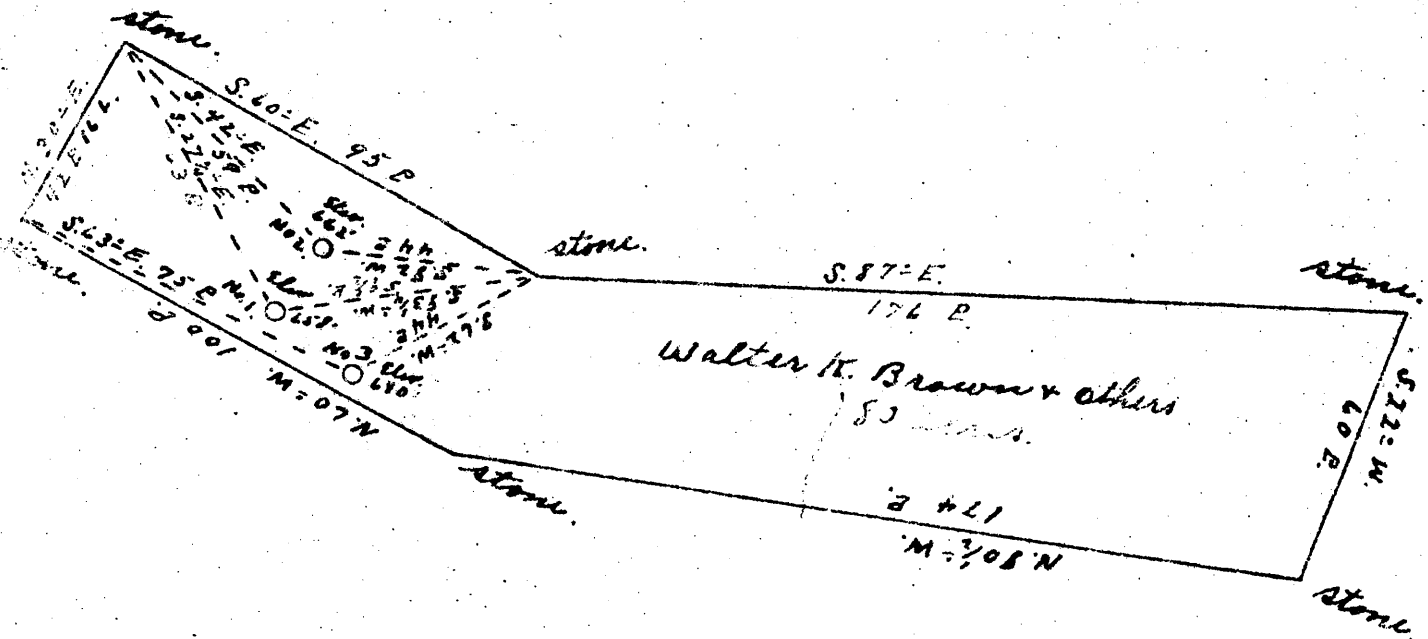

O.T. Smith

Oli Haught

# 1	0.43 W 1.47 S
# 2	0.4 W 1.39 S
# 3	0.3 W 1.45 S

New Location
 Drill Deeper
 Abandonment

JAN 13 1947

1947?

Company Sugarcamp Oil Co.
 Address New Matmoras Ohio
 Farm Walter K. Brown & others
 Tract _____ Acres 80 Lease No. _____
 Well (Farm) No. 4, 2, & 3 Serial No. _____
 Elevation (Spirit Level) No. 1, 658' No. 2, 662' No. 3, 660'
 Quadrangle St. Marys W.Va.
 County Tyler District Union
 Engineer Jno Triplett
 Engineer's Registration No. _____
 File No. _____ Drawing No. _____
 Date Oct. 25, 1946 Scale 1" = 40 P.

STATE OF WEST VIRGINIA
 DEPARTMENT OF MINES
 OIL AND GAS DIVISION
 CHARLESTON

WELL LOCATION MAP
 FILE NO. TYL-410-A; #1

TYL-411-A; #2 - TYL-412-A; #3
 Denotes location of well on United States Topographic Maps, scale 1 to 62,500, latitude and longitude lines being represented by border lines, as shown.

- Denotes one inch spaces on border line of original tracing.