


S. Purkes  
S. 86. E. 390 P.

E. 200 P.  
E. 65 P.  
W. 192 P.

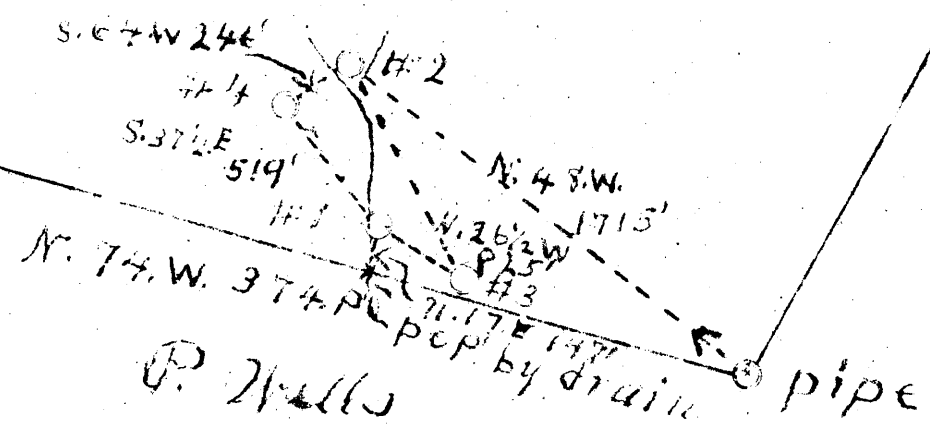

O. J. Smith

P. Wells

|    |                |
|----|----------------|
| #1 | 4.07 W<br>1.80 |
| #3 | 3.98 W<br>1.85 |

✓ ✓  
347

New Location   
Drill Deeper   
Abandonment

Company Brown Mrs. & Monteith  
 Address New Mountmorris Clinic  
 Farm O. J. Smith  
 Tract 1 Acres 314 Lease No. (3) NC?  
 Well (Farm) No. 1 & 3 Serial No. (11) NE  
 Elevation (Spirit Level) 1-803.73, 3. 2. 7. 7.  
 Quadrangle St. Marys  
 County Tyler District Union  
 Engineer J. S. Haught  
 Engineer's Registration No. CO. Senior  
 File No. \_\_\_\_\_ Drawing No. \_\_\_\_\_  
 Date 4-17-40 Scale 1" = 40 Tds

STATE OF WEST VIRGINIA  
DEPARTMENT OF MINES  
OIL AND GAS DIVISION  
CHARLESTON

WELL LOCATION MAP  
FILE NO. TYL-416-A; #1

TYL-413-A; #3  
+ Denotes location of well on United States Topographic Maps, scale 1 to 62,500. latitude and longitude lines being represented by border lines as shown.  
- Denotes one inch spaces on border line of original tracing.

1947