

New Location
 Drill Deeper
 Abandonment

Company American Oil Development Co.
 Address Sistersville West Virginia
 Farm ELI Flesher Hrs.
 Tract No 2 Acres 125 Lease No. _____
 Well (Farm) No. 1x2 Serial No. _____
 Elevation (Spirit Level) #1 - 803.49 #2 - 802.36
 Quadrangle West Union **WC**
 County Tyler District Meade
 Engineer J. S. Haught
 Engineer's Registration No. Tyler Co. County Surveyor
 File No. _____ Drawing No. _____
 Date 4-9-46 Scale 40 vds = 1 inch

STATE OF WEST VIRGINIA
 DEPARTMENT OF MINES
 OIL AND GAS DIVISION
 CHARLESTON

WELL LOCATION MAP
 FILE NO. JYL-430-A-#2
JYL-431-A-#1

+ Denotes location of well on United States Topographic Maps, scale 1 to 62,500, latitude and longitude lines being represented by border lines as shown.

- Denotes one inch spaces on border line of original tracing.



726

STATE OF WEST VIRGINIA
DEPARTMENT OF MINES
OIL AND GAS DIVISION

WELL RECORD

Permit No. 430-A

Oil or Gas Well Oil Well
(KIND)


Company American Oil Development Company
Address Sistersville, West Virginia.
Farm Eli Flesher Heirs Acres 250
Location (waters) Sugar Creek
Well No. Two Elev. 882.36
District Meade County Tyler
The surface of tract is owned in fee by C. F. Gorrell
Address Meadville, W. Va.
Mineral rights are owned by Wm. Morris Hrg. & C. F. Gorrell
Address Meadville, W. Va.
Drilling commenced July 11th, 1896
Drilling completed August 12, 1896
Date Shot 6-26-22 From 1813 To 1828
With 30 quarts

Casing and Tubing	Used in Drilling	Left in Well	Packers
Size			Kind of Packer
16			
13 <u>Cond.</u>	<u>I2</u>	<u>I2</u>	<u>Disc Wall</u>
10			Size of <u>4-7/8x6 1/2</u>
8 1/4	<u>990</u>		
6 1/2	<u>I465</u>	<u>I465</u>	Depth set <u>I486</u>
5 3/16			
3			Perf. top
2			Perf. bottom
Liners Used			Perf. top
			Perf. bottom

Open Flow /10ths Water in _____ Inch
/10ths Merc. in _____ Inch
Volume _____ Cu. Ft.
Rock Pressure _____ lbs. _____ hrs.
Oil _____ bbls., 1st 24 hrs.
Fresh water _____ feet _____ feet
Salt water _____ feet _____ feet

CASING CEMENTED _____ SIZE _____ No. Ft. _____ Date _____
COAL WAS ENCOUNTERED AT _____ FEET _____ INCHES
_____ FEET _____ INCHES _____ FEET _____ INCHES
_____ FEET _____ INCHES _____ FEET _____ INCHES

Formation	Color	Hard or Soft	Top	Bottom	Oil, Gas or Water	Depth Found	Remarks
Cow Run Sand			990	1010			
Salt Sand			1180	1480			
Limestone			1700	1760			
Break			1788	1792			
Big Injun			1792				
Gas			1792				
Oil			1812	1822			
Total Depth			1830				

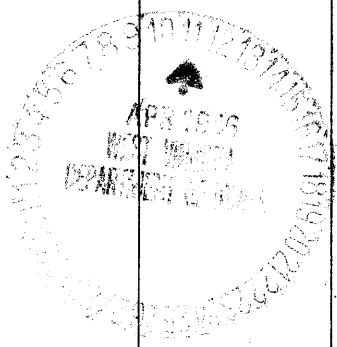

Formation	Color	Hard or Soft	Top	Bottom	Oil, Gas or Water	Depth Found	Remarks

Date April 10th, 1946., 194

APPROVED American Oil Development Co., Owner

By Walter H. Rags.
(Title) Sup't