

New Location
 Drill Deeper
 Abandonment

Company American Oil Development Co.
 Address Sistersville West Virginia
 Farm ELI Flesher Hrs.
 Tract No 2 Acres 125 Lease No. _____
 Well (Farm) No. 1 x 2 Serial No. _____
 Elevation (Spirit Level) #1 - 803.49 #2 - 802.36
 Quadrangle West Union WC
 County Tyler District Meade
 Engineer J. S. Haught
 Engineer's Registration No. _____
 File No. _____ Drawing No. _____
 Date 4-9-46 Scale 40 vds = 1 inch

STATE OF WEST VIRGINIA
 DEPARTMENT OF MINES
 OIL AND GAS DIVISION
 CHARLESTON

WELL LOCATION MAP
 FILE NO. JYL-430-A-#2
JYL-431-A-#1

+ Denotes location of well on United States Topographic Maps, scale 1 to 62,500, latitude and longitude lines being represented by border lines as shown.
 - Denotes one inch spaces on border line of original tracing.



STATE OF WEST VIRGINIA
DEPARTMENT OF MINES
OIL AND GAS DIVISION

477

WELL RECORD

AD 431-A
Permit No. _____

Oil or Gas Well Oil Well
(KIND)


Company American Oil Development Co.,
 Address Sistersville, West Virginia.
 Farm Eli Fleisher Heirs Acres 250
 Location (waters) Sugar Creek
 Well No. One Elev. 803.49
 District Meade County Tyler
 The surface of tract is owned in fee by C. F. Gorrell
Meadeville, W. Va. Address _____
 Mineral rights are owned by Wm. Morris Hrs., & C. F.
Gorrell, Address Meadeville, W. Va.
 Drilling commenced June 13th, 1900
 Drilling completed July 7th, 1900
 Date Shot 7-8-00 From 1777 To 1781
 With 40 quarts
 Open Flow _____ /10ths Water in _____ Inch
 _____ /10ths Merc. in _____ Inch
 Volume _____ Cu. Ft.
 Rock Pressure _____ lbs. _____ hrs.
 Oil _____ bbls., 1st 24 hrs.
 Fresh water _____ feet _____ feet
 Salt water _____ feet _____ feet

Casing and Tubing	Used in Drilling	Left in Well	Packers
Size			
16			Kind of Packer _____
13 <u>Cond</u>	<u>5 1/2</u>		<u>Disc Wall</u>
10	<u>I40</u>		Size of <u>4-7/8x6 1/2</u>
8 1/4	<u>860</u>		
6 1/4	<u>I400</u>	<u>I400</u>	Depth set <u>I034</u>
5 3/16 <u>4 7/8</u>	<u>1</u>	<u>1034'</u>	
3			Perf. top _____
2			Perf. bottom _____
Liners Used			Perf. top _____
			Perf. bottom _____

CASING CEMENTED _____ SIZE _____ No. Ft. _____ Date _____

COAL WAS ENCOUNTERED AT _____ FEET _____ INCHES
 _____ FEET _____ INCHES _____ FEET _____ INCHES
 _____ FEET _____ INCHES _____ FEET _____ INCHES

Formation	Color	Hard or Soft	Top	Bottom	Oil, Gas or Water	Depth Found	Remarks
Cow Run Sand			960	960			
Salt Sand			1254	1305			
Limestone			1612	1698			
Break			1697	1700			
Big Injun			1700				
Oil Pay			1736				
Oil Pay			1777	1781			
Total Depth			1787				

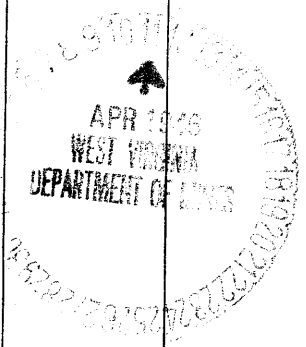

Formation	Color	Hard or Soft	Top	Bottom	Oil, Gas or Water	Depth Found	Remarks

Date April 10th, 1946., 194

APPROVED American Oil Development Company Owner

By Walter H. Days
(Title)



ELI FLESHER HEIRS NO. 1 WELL.

Meade District, Tyler County, W. Va. 131A
 By American Oil Development Co., Sistersville, W. Va.
 Abandoned ~~under~~ under permit Tyl-.....-A?
 On 250 acres, on Sugar Creek.
 Elevation, 903.49' L.
 Surface owned by C. F. Gorrell, Meadville, W. Va., and minerals by
 Wm. Morris Heirs and C. F. Gorrell, Meadville, W. Va.
 Drilling commenced June 13, 1900; completed July 7, 1900.
 Shot July 8, 1900, at 1777-1781', with 40 qts.
 13" conductor, 5½'; 10" casing, 140' (pulled); 8¼", 860' (pulled);
 6¼", 1400'; 4-7/8", 1034'.
 Disc wall packer, 4-7/8 x 6¼, set at 1034'.
 Oil well. Abandonment reported to Dept. of Mines April 10, 1946.
 Record to RCT from Mrs. Griffith Feb. 17, 1949. Old File No. 477.

	Top.	Bottom.
Cow Run Sand	960	- 968
Salt Sand	1254	- 1305
Limestone	1612	- 1697
Break	1697	- 1700
Big Injun Sand (oil pay, 1736') (oil pay, 1777-1781')	1700	-
Total depth		1787