

New Location   
 Drill Deeper   
 Abandonment

✓ SEP 16 1947

Handwritten notes:  
 #10  
 0.18 W  
 2.89  
 0.28 W  
 2.9

Company <b>SMITH, PIERSOL, FEICK &amp; COSS</b>	
Address <b>WALKER ROUTE NO. 2</b>	
Farm <b>ELK MORGAN</b>	
Tract _____	Acres <b>59 3/4</b> Lease No. _____
Well (Farm) No. <b>6 &amp; 10</b>	Serial No. _____
Elevation (Spirit Level) <b>No 6: 805 - No 10: 800</b>	
Quadrangle <b>ST MARYS</b>	
County <b>TYLER</b>	District <b>MEADE</b>
Engineer <b>L. G. McRILL</b>	
Engineer's Registration No. _____	<b>152</b>
File No. _____	Drawing No. _____
Date <b>SEPT. 5, 1947</b>	Scale <b>400' = 1"</b>

STATE OF WEST VIRGINIA  
 DEPARTMENT OF MINES  
 OIL AND GAS DIVISION  
 CHARLESTON

**WELL LOCATION MAP**  
 FILE NO. **JYL-464-A-#6**  
**JYL-465-A-#10**

+ Denotes location of well on United States Topographic Maps, scale 1 to 62,500. Latitude and longitude lines being represented by border lines as shown

- Denotes one inch spaces on border line of original tracing



STATE OF WEST VIRGINIA  
DEPARTMENT OF MINES  
OIL AND GAS DIVISION

*J. M.*

WELL RECORD

Permit No. 465-A

Oil or Gas Well Oil  
(KIND)


Company Smith, Pierson, Feick & Coss  
Address Walker, Route 2, W. Va.  
Farm J. D. Livingston Acres 69-3/4  
Location (waters) McKim Creek  
Well No. 10 Elev. 890  
District Meade County Tyler  
The surface of tract is owned in fee by Elk Morgan  
Address Pennsboro, W. Va.  
Mineral rights are owned by John May & Mary E. Wable  
Mary E. Wable, Atty. Address Friendly, W. Va.  
Drilling commenced 1897  
Drilling completed 1897  
Date Shot \_\_\_\_\_ From \_\_\_\_\_ To \_\_\_\_\_  
With \_\_\_\_\_  
Open Flow \_\_\_\_\_ /10ths Water in \_\_\_\_\_ Inch  
\_\_\_\_\_ /10ths Merc. in \_\_\_\_\_ Inch  
Volume \_\_\_\_\_ Cu. Ft.  
Rock Pressure \_\_\_\_\_ lbs. \_\_\_\_\_ hrs.  
Oil \_\_\_\_\_ bbls., 1st 24 hrs.  
Fresh water \_\_\_\_\_ feet \_\_\_\_\_ feet  
Salt water \_\_\_\_\_ feet \_\_\_\_\_ feet

Casing and Tubing	Used in Drilling	Left in Well	Packers
Size			Kind of Packer
16			
13			
10	180	Pull Out	Size of
8 1/4	1020	" "	
6 1/2	1740	1740	Depth set
5 3/16			
3			Perf. top
2			Perf. bottom
Liners Used			Perf. top
			Perf. bottom

CASING CEMENTED \_\_\_\_\_ SIZE \_\_\_\_\_ No. Ft. \_\_\_\_\_ Date \_\_\_\_\_  
COAL WAS ENCOUNTERED AT \_\_\_\_\_ FEET \_\_\_\_\_ INCHES  
\_\_\_\_\_ FEET \_\_\_\_\_ INCHES FEET \_\_\_\_\_ INCHES  
\_\_\_\_\_ FEET \_\_\_\_\_ INCHES FEET \_\_\_\_\_ INCHES

Formation	Color	Hard or Soft	Top	Bottom	Oil, Gas or Water	Depth Found	Remarks
1st Cow Run Sand			940	955			
2nd Salt Sand			1045	1145			
Big Line			1736	1843			
Big Injun			1843	1893			
Gas			1843				
Oil			1853				
Total depth				1893			

Record furnished by the South Penn Natural Gas Company.

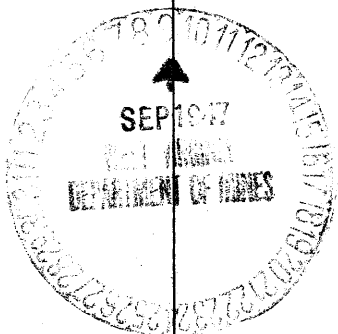

Formation	Color	Hard or Soft	Top	Bottom	Oil, Gas or Water	Depth Found	Remarks

Date September 5, 1947

APPROVED Smith Piersol Feick & Coss, Owner

By E R Piersol  
(Title)

J. D. LIVINGSTON NO. 10 WELL.

465A

Meade District, Tyler County, W. Va.

By Smith, Piersol, Feick & Coss, Route 2, Walker, W. Va.

Abandoned under permit Tyl-.....-A?.

On  $69\frac{3}{4}$  acres, on McKim Creek.

Elevation, 890' L.

Surface owned by Elk Morgan, Pennsboro, W. Va., and minerals by

John May and Mary E. Wable, Mary E. Wable, Atty., Friendly, W. Va.

Drilling commenced and completed in 1897.

10" casing, 180' (pulled);  $8\frac{1}{4}$ " , 1020' (pulled);  $6\frac{1}{2}$ " , 1740'.

Oil well. Record to Dept. of Mines dated Sept. 5, 1947.

Record furnished by the South Penn Natural Gas Company.

Record to RCT from Mrs. Griffith September 14, 1949. Old File No. 521.

	Top.	Bottom.
1st Cow Run Sand	940	- 955
2nd Salt Sand	1045	- 1445
Big Lime	1736	- 1843
Big Injun Sand (gas, 1843'; oil, 1853')	1843	- 1893
Total depth		1893