

New Location
 Drill Deeper
 Abandonment

DEC 16 1947

# 9	3,222 W 2,172 S
# 10	3,111 W 2,115 S
# 6	3,110 W 2,227 S
# 13	2,988 W 2,225 S

Company E.S. Woodyard
 Address Pennsboro, W.Va.
 Farm J.L. Poe
 Tract Acres 150 Lease No. _____
 Well (Farm) No. 6-9-10-13 Serial No. _____
 Elevation (Spirit Level) 943-1119-949-1023
 Quadrangle West Union W.C.
 County Tyler District Meade
 Engineer C.T. Westfall
 Engineer's Registration No. _____
 File No. _____ Drawing No. _____
 Date Sept. 29, 1947 Scale 1" = 40 Poles

STATE OF WEST VIRGINIA
 DEPARTMENT OF MINES
 OIL AND GAS DIVISION
 CHARLESTON

WELL LOCATION MAP

FILE NO. JYL-467-A-#13
JYL-468-A-#6
JYL-469-A-#9
JYL-473-A-#10

+ Denotes location of well on United States Topographic Maps, scale 1 to 62,500, latitude and longitude lines being represented by border lines as shown.

- Denotes one inch spaces on border line of original tracing.



STATE OF WEST VIRGINIA
DEPARTMENT OF MINES
OIL AND GAS DIVISION

WELL RECORD

Oil or Gas Well Oil (KIND)


Permit No. 460-7

Company E.S. Woodyard
Address Pennsboro, W. Va.
Farm J.L. Poe Acres 100
Location (waters) _____
Well No. 6 Elev. 943
District Meade County Tyler
The surface of tract is owned in fee by Unknown
Address _____
Mineral rights are owned by South Penn Nat. Gas Co.
Address Parkersburg, W. Va.
Drilling commenced Unknown
Drilling completed Unknown
Date Shot 5-14-37 From 1052 To 1056
With " & 3 qts. -5 gts.
Open Flow /10ths Water in _____ Inch
/10ths Merc. in _____ Inch
Volume _____ Cu. Ft.
Rock Pressure _____ lbs. _____ hrs.
Oil _____ bbls., 1st 24 hrs.
Fresh water _____ feet _____ feet
Salt water _____ feet _____ feet

Casing and Tubing	Used in Drilling	Left in Well	Packers
Size			
16			Kind of Packer
13			
10	232	232	Size of
8 1/4			
6 1/2	1047	1047	Depth set
5 1/8			
4 7/8	747	747	Perf. top
4	1060	1060	Perf. bottom
Liners Used			Perf. top
			Perf. bottom

CASING CEMENTED _____ SIZE _____ No. Ft. _____ Date _____
COAL WAS ENCOUNTERED AT _____ FEET _____ INCHES
_____ FEET _____ INCHES _____ FEET _____ INCHES
_____ FEET _____ INCHES _____ FEET _____ INCHES

Formation	Color	Hard or Soft	Top	Bottom	Oil, Gas or Water	Depth Found	Remarks
Red Rock Cave 1st Cow Run Oil			770 1050 1052	940 1081 1081	Oil	1052	
				1081' (1081')			

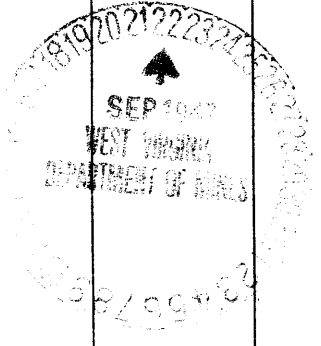

APR 81948

Formation	Color	Hard or Soft	Top	Bottom	Oil, Gas or Water	Depth Found	Remarks

Date Sept. 20, 1947
APPROVED C. Lusodyan, Owner
By Owner
(Title)



462

Meade District, Tyler County, W. Va.
Carter Oil Co.
3/4 mi. N. W. of McKim P. O.
Completed, Oct. 12, 1901.
150-bbl. Cow Run oil. Best well in field.

7

	Top.	Bottom.
Cave, soft	770	940
1 Cow Run Sand, good and soft (150-bbl. well at 1052')	1050	1081
Total depth		1081