

New Location   
 Drill Deeper   
 Abandonment

Company Pittsburgh Oil & Gas Company  
 Address 841 Henry Oliver Building  
Pittsburgh  
 Farm C. A. Watkins  
 Tract 1 Acres 27 Lease No. \_\_\_\_\_  
 Well (Farm) No. 1 Serial No. \_\_\_\_\_  
 Elevation (Spirit Level) 748'  
 Quadrangle New Martinsville  
 County Tyler District Ellsworth  
 Engineer Don L. Piquette  
 Engineer's Registration No. \_\_\_\_\_  
 File No. 1031 Drawing No. \_\_\_\_\_  
 Date 2-19-'48 Scale 1" = 30'

STATE OF WEST VIRGINIA  
 DEPARTMENT OF MINES  
 OIL AND GAS DIVISION  
 CHARLESTON

WELL LOCATION MAP  
 FILE NO. JYL-475-A

+ Denotes location of well on United States Topographic Maps, scale 1 to 62,500, latitude and longitude lines being represented by border lines as shown.  
 - Denotes one inch spaces on border line of original tracing.



STATE OF WEST VIRGINIA  
DEPARTMENT OF MINES  
OIL AND GAS DIVISION

473

AP 475-A

WELL RECORD

Oil or Gas Well \_\_\_\_\_ (KIND)

Permit No. 475-A


Company Pittsburg Oil & Gas Company,  
Address 811 Oliver Building, Pittsburgh, Pa.  
Farm C.A. Watkins Acres 27  
Location (waters) \_\_\_\_\_  
Well No. 1 Elev. \_\_\_\_\_  
District Ellsworth County Tyler  
The surface of tract is owned in fee by \_\_\_\_\_  
Address \_\_\_\_\_  
Mineral rights are owned by C.A. Watkins,  
Address Rt. #1, New Martinsville, W. Va.  
Drilling commenced \_\_\_\_\_  
Drilling completed August, 1929  
Date Shot \_\_\_\_\_ From \_\_\_\_\_ To \_\_\_\_\_  
With \_\_\_\_\_  
Open Flow \_\_\_\_\_ /10ths Water in \_\_\_\_\_ Inch  
\_\_\_\_\_ /10ths Merc. in \_\_\_\_\_ Inch  
Volume \_\_\_\_\_ Cu. Ft.  
Rock Pressure \_\_\_\_\_ lbs. \_\_\_\_\_ hrs.  
Oil \_\_\_\_\_ bbls., 1st 24 hrs.  
Fresh water \_\_\_\_\_ feet \_\_\_\_\_ feet  
Salt water \_\_\_\_\_ feet \_\_\_\_\_ feet

Casing and Tubing	Used in Drilling	Left in Well	Packers
Size			Kind of Packer
16			<u>Permace</u>
13			Size of <u>3"</u>
10		<u>118</u>	Depth set <u>1511</u>
8 1/4		<u>895</u>	
6 3/8			Perf. top _____
5 3/16			Perf. bottom _____
3			Perf. top _____
2		<u>1511</u>	Perf. bottom _____
Liners Used			Perf. top _____
			Perf. bottom _____

CASING CEMENTED \_\_\_\_\_ SIZE \_\_\_\_\_ No. Ft. \_\_\_\_\_ Date \_\_\_\_\_

COAL WAS ENCOUNTERED AT \_\_\_\_\_ FEET \_\_\_\_\_ INCHES  
\_\_\_\_\_ FEET \_\_\_\_\_ INCHES FEET \_\_\_\_\_ INCHES  
\_\_\_\_\_ FEET \_\_\_\_\_ INCHES FEET \_\_\_\_\_ INCHES

Formation	Color	Hard or Soft	Top	Bottom	Oil, Gas or Water	Depth Found	Remarks
White sand			895	955			
<del>Marion</del> <u>Sand</u>			1505	1595	Gas	1562-1595	
TOTAL DEPTH				1600			

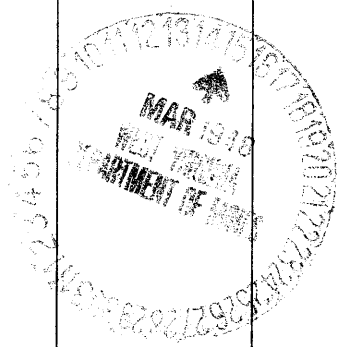

Formation	Color	Hard or Soft	Top	Bottom	Oil, Gas or Water	Depth Found	Remarks

Date March 9, 1948, 194

APPROVED Pittsburg Oil & Gas Company, Owner

By *J.H. Jackson*  
(Title) V.P. & Gen'l Mgr

