

APR 26 1948

(Note - Elevations run by Hope Construction & Refining Co.'s Engineers.)

New Location

Drill Deeper

Abandonment

Company Frank Lando

Address Box 356 Bellair, Ohio

Farm N. Salisbury

Tract 1 Acres 240 Lease No. 8-8-11-12-10

Well (Farm) No. 14-2-9-23 Serial No. (92)

Elevation (Spirit Level) 3-838' 9-888' 10-879'

Adtriangle New Martinsville

County Tyler District Lincoln

Surveyor Donald J. Giggles

Surveyor's Registration No. 046-1

Drawing No. Aug. 647, 47 Scale 1" = 60 f

STATE OF WEST VIRGINIA
DEPARTMENT OF MINES
OIL AND GAS DIVISION

JYL-478-A-#8 CHARLESTON JYL-480-A-#10

JYL-479-A-#9 JYL-481-A-#11

WELL LOCATION MAP

FILE NO. JYL-482-A-#12

JYL-440-A-#1 JYL-483-A-#14

JYL-441-A-#3 JYL-484-A-#23

+ Denotes location of well on United States
Topographic Maps, scale 1 to 62,500; lat-
itude and longitude lines being represented
by border lines as shown.

- Denotes one inch spaces on border line
of original tracing.



745

STATE OF WEST VIRGINIA
DEPARTMENT OF MINES
OIL AND GAS DIVISION

WELL RECORD

Permit No. _____

Oil or Gas Well 011
(KIND)


Company Frank Lando
 Address Box 356 - Bellaire, Ohio
 Farm N. Salisbury Acres 240
 Location (waters) Slaughter House Run
 Well No. 12 Twelve Elev. 1049'
 District Lincoln County Tyler
 The surface of tract is owned in fee by N. Salisbury
Heirs Address Sistersville
 Mineral rights are owned by Mrs. Mazie Manning and
Ira Salisbury Address Sistersville
 Drilling commenced July 28, 1893
 Drilling completed August 31, 1893
 Date Shot 5/11/98 From 1841 To 1851
 With 10 Quarts
 Open Flow /10ths Water in _____ Inch
 /10ths Merc. in _____ Inch
 Volume _____ Cu. Ft.
 Rock Pressure _____ lbs. _____ hrs.
 Oil 75 bbls., 1st 24 hrs.
 Fresh water _____ feet _____ feet
 Salt water _____ feet _____ feet

Casing and Tubing	Used in Drilling	Left in Well	Packers
Size			
16			Kind of Packer _____
13			<u>Larkin</u>
10			Size of _____
8 1/4			<u>6 1/2" x 4-7/8"</u>
6 5/8	<u>1200'</u>	<u>1200'</u>	Depth set _____
<u>4-7/8"</u>	<u>1252'</u>	<u>1252'</u>	<u>1252'</u>
3			Perf. top _____
2 Tbg.		<u>1873'</u>	Perf. bottom _____
Liners Used			Perf. top _____
			Perf. bottom _____

CASING CEMENTED _____ SIZE _____ No. Ft. _____ Date _____

COAL WAS ENCOUNTERED AT _____ FEET _____ INCHES
 _____ FEET _____ INCHES _____ FEET _____ INCHES
 _____ FEET _____ INCHES _____ FEET _____ INCHES

Formation	Color	Hard or Soft	Top	Bottom	Oil, Gas or Water	Depth Found	Remarks
First Salt			1275'				
Big Lime			1710'	1780'			
Big Injun			1838'				
Oil			1842'				
Total Depth				1883'			

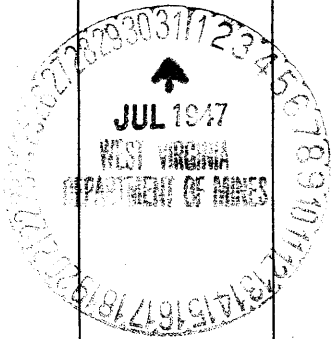

Formation	Color	Hard or Soft	Top	Bottom	Oil, Gas or Water	Depth Found	Remarks

Date _____, 19____
 APPROVED Frank Lando, Owner
 By _____ (Title)

