

New Location
 Drill Deeper
 Abandonment

✓ ✓ ✓ MAY 16 1948 #3

Company J.R. Bull
 Address Sistersville, W. Va.
 Farm M. H. Gorrell
 Tract 1 Acres 63 Lease No. 81328
 Well (Farm) Nos. 2, 3 & 4 Serial No. _____
 Elevation (Spirit Level) 2-1138, 3-1013, 4-1010
 Quadrangle New Martinsville (50)
 County Tyler District Ellsworth
 Engineer Don L. Riggle
 Engineer's Registration No. _____
 File No. D & G-S.P. 11 Drawing No. 1377
 Date Apr. 10, 1948 Scale 1" = 40'


STATE OF WEST VIRGINIA
 DEPARTMENT OF MINES
 OIL AND GAS DIVISION
 CHARLESTON

WELL LOCATION MAP

FILE NO. JYL-491-A-#4
JYL-493-A-#2
JYL-494-A-#3

+ Denotes location of well on United States Topographic Maps, scale 1 to 82,500, latitude and longitude lines being represented by border lines as shown.

- Denotes one inch spaces on border line of original tracing.

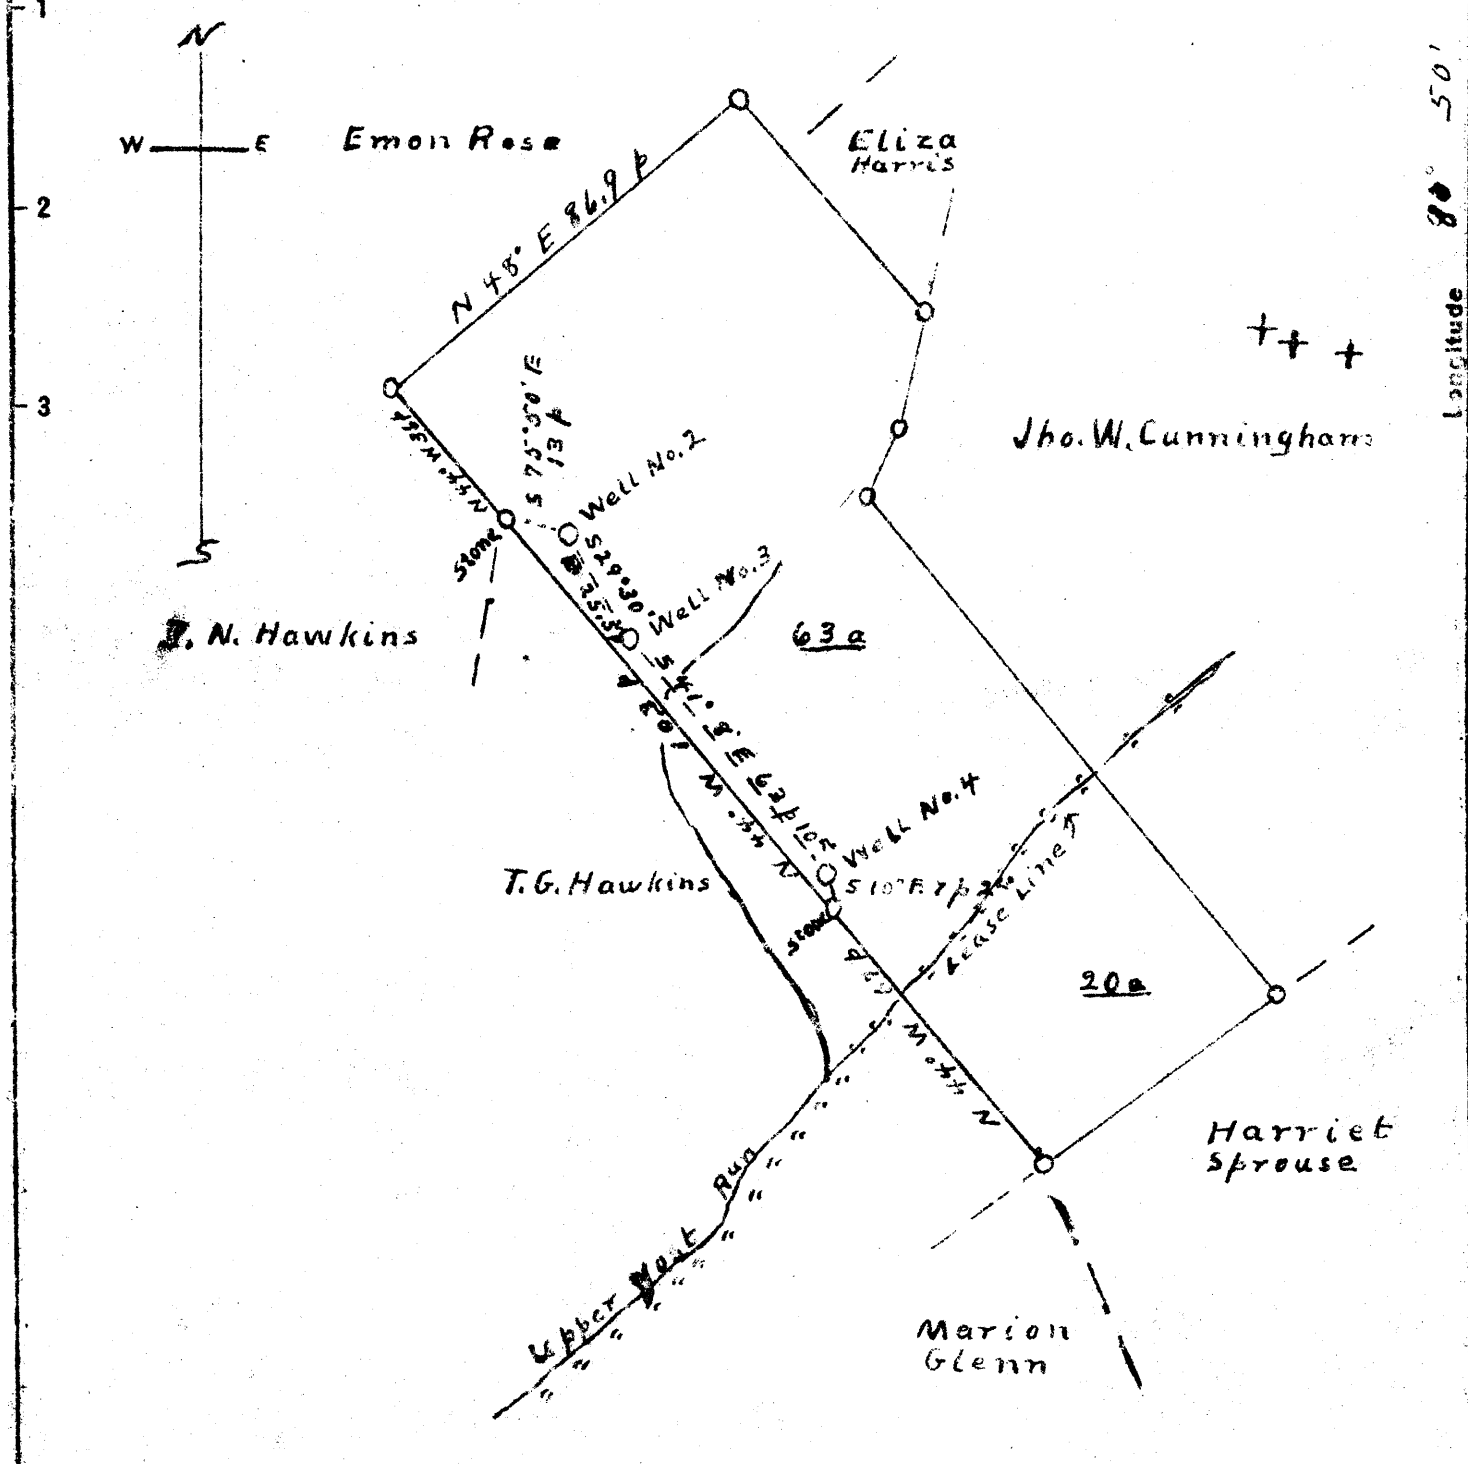

New Location
 Drill Deeper
 Abandonment

Company J.R. Bull
 Address Sistersville, W.Va.
 Farm M. H. Gorrell
 Tract 1 Acres 63 Lease No. 81328
 Well (Farm) Nos. 2, 3 & 4 Serial No. _____
 Elevation (Spirit Level) 2-1138, 3-1213, 4-1010
 Quadrangle New Martinsville
 County Tyler District Ellsworth
 Engineer Don L. Riggle
 Engineer's Registration No. _____
 File No. 046-S.P. 10 Drawing No. 1277
 Date Apr. 10, 1948 Scale 1" = 40 p

STATE OF WEST VIRGINIA
 DEPARTMENT OF MINES
 OIL AND GAS DIVISION
 CHARLESTON

WELL LOCATION MAP

FILE NO. JYL-491-A-#4
JYL-493-A-#2
JYL-494-A-#3

+ Denotes location of well on United States Topographic Maps, scale 1 to 62,500, latitude and longitude lines being represented by border lines as shown.

- Denotes one inch spaces on border line of original tracing.