

New Location   
 Drill Deeper   
 Abandonment

Company Smith, Pierson, Feick & Coss  
 Address R.D. #2 Walker, W.Va.  
 Farm Ashford Broadwater  
 Tract \_\_\_\_\_ Acres 575 Lease No. \_\_\_\_\_  
 Well (Farm) No. 14, 15 & 21 Serial No. \_\_\_\_\_  
 Elevation (Spirit Level) 894.8 927.8 965.4  
 Quadrangle West Union  
 County Tyler District Meade  
 Engineer Q. Meredith Wood Co. Deputy Surveyor  
 Engineer's Registration No. \_\_\_\_\_  
 File No. \_\_\_\_\_ Drawing No. \_\_\_\_\_  
 Date July 12, 1948 Scale 1 in. = 40 Poles

STATE OF WEST VIRGINIA  
 DEPARTMENT OF MINES  
 OIL AND GAS DIVISION  
 CHARLESTON

WELL LOCATION MAP

FILE NO. JYL-498-A-#21  
JYL-499-A-#15  
JYL-500-A-#14

+ Denotes location of well on United States Topographic Maps, scale 1 to 62,500, latitude and longitude lines being represented by border lines as shown.

- Denotes one inch spaces on border line of original tracing.

ASHFORD BROADWATER TRACTS 7, 15 & 21 - SMITH, PIERSON, FEICK & COSS - TYL-498-500-A



STATE OF WEST VIRGINIA  
DEPARTMENT OF MINES  
OIL AND GAS DIVISION

523

WELL RECORD

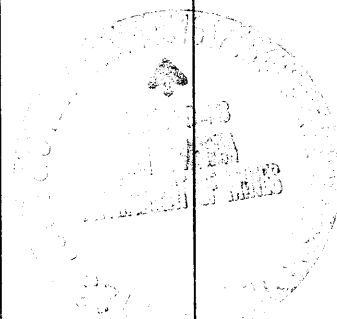
Oil or Gas Well X (KIND)

Permit No. 100-A

Company Smith, Piersol, Peick & Coss  
 Address R.F.D. Walker, R.F. D. No. 2.  
 Farm Hugh Smith Acres 575  
 Location (waters) McKim Creek  
 Well No. 14 Elev. 894.8  
 District Hoade County Tyler  
 The surface of tract is owned in fee by Hugh Smith,  
 Address Wick, W. Va.  
 Mineral rights are owned by Ralph Broadwater  
 Address Sistersville, W. Va.  
 Drilling commenced Old- no record  
 Drilling completed \_\_\_\_\_  
 Date Shot \_\_\_\_\_ From \_\_\_\_\_ To \_\_\_\_\_  
 With \_\_\_\_\_  
 Open Flow \_\_\_\_\_ /10ths Water in \_\_\_\_\_ Inch  
 \_\_\_\_\_ /10ths Merc. in \_\_\_\_\_ Inch  
 Volume \_\_\_\_\_ Cu. Ft.  
 Rock Pressure \_\_\_\_\_ lbs. \_\_\_\_\_ hrs.  
 Oil \_\_\_\_\_ bbls., 1st 24 hrs.  
 Fresh water \_\_\_\_\_ feet \_\_\_\_\_ feet  
 Salt water \_\_\_\_\_ feet \_\_\_\_\_ feet

Casing and Tubing	Used in Drilling	Left in Well	Packers
Size			Kind of Packer
16			
13			Size of
10			Depth set
8 1/4	345	345	
6 1/4	920	920	
5 5/16			Perf. top
2			Perf. bottom
Liners Used			Perf. top
			Perf. bottom

CASING CEMENTED \_\_\_\_\_ SIZE \_\_\_\_\_ No. Ft. \_\_\_\_\_ Date \_\_\_\_\_  
 COAL WAS ENCOUNTERED AT \_\_\_\_\_ FEET \_\_\_\_\_ INCHES  
 \_\_\_\_\_ FEET \_\_\_\_\_ INCHES FEET \_\_\_\_\_ INCHES  
 \_\_\_\_\_ FEET \_\_\_\_\_ INCHES FEET \_\_\_\_\_ INCHES

Formation	Color	Hard or Soft	Top	Bottom	Oil, Gas or Water	Depth Found	Remarks
1st Cow Run			938	961			
Gas			938				
Oil			940	946			
Total Depth				961			
This record furnished by South Penn Natural Gas Co., from whom well was purchased.							
							

C

Formation	Color	Hard or Soft	Top	Bottom	Oil, Gas or Water	Depth Found	Remarks

Date 7 14, 1948

APPROVED Smith Piersol Egan & Sons, Owner

By C A Piersol  
(Title)



HUGH SMITH NO. 14 WELL.

570A

Meade District, Tyler County, W. Va.

By Smith, Piersol, Feick & Coss, R. F. D. No. 2, Walker, W. Va.

Abandoned under permit Tyl--.....-A?

On 575 acres, on McKim Creek.

Elevation, 894.8' L.

Surface owned by Hugh Smith, Wick, W. Va., and minerals by Ralph Broadwater, Sistersville, W. Va.

Date of completion, not given. "Old--no record".

8 $\frac{1}{4}$ " casing, 345'; 6 $\frac{1}{4}$ " , 920'; all left in.

This record furnished by South Penn Natural Gas Co. from whom well was purchased.

Oil well. Record to Dept. of Mines dated July 14, 1948.

Record to RCT from Mrs. Griffith September 14, 1949. Old File No. 523.

	Top.	Bottom.
1st Cow Run Sand (gas, 938'; oil, 940-946')	938	961
Total depth		961