

COAL OWNED BY G. Thompson Yorba Linda, Calif.
A. J. Myers, Lima W. Va.
Clarissa Parks, Jacksonburg W. Va.
Daisy Thompson, Lima W. Va.

NEW LOCATION
 DRILL DEEPER
 ABANDONMENT

COMPANY The Manufacturers Light & Heat Co
 ADDRESS 800 Union Trust Building, Pittsburgh Pa.
 FARM Henry & Daisy Thompson
 TRACT 102 LEASE NO. 6895
 WELL (FARM) NO. 2742
 ELEVATION (SPIRIT LEVEL) 1170'
 QUADRANGLE Centerpoint W. Va.
 COUNTY Tyler DISTRICT McElroy
 ENGINEER John A. London
 ENGINEER'S REGISTRATION NO. 12710
 FILE NO. Y-13-74
 DATE July 23 1918 SCALE 1" = 800'

STATE OF WEST VIRGINIA
 DEPARTMENT OF MINES
 OIL AND GAS DIVISION
 CHARLESTON

WELL LOCATION MAP
 No. JYL-502-A

INDICATED LOCATION OF WELL ON UNITED STATES TOPOGRAPHIC MAPS SCALE 1 TO 62,500. LATITUDE AND LONGITUDE LINES BEING REPRESENTED BY BORDER LINES AS SHOWN.
 X DENOTES ONE INCH SPACES ON BORDER LINE OF ORIGINAL TRACING.



STATE OF WEST VIRGINIA
DEPARTMENT OF MINES
OIL AND GAS DIVISION

172

WELL RECORD

Permit No. 502-A

Oil or Gas Well Gas
(KIND)

Company The Manufacturers Light & Heat Company
Address 800 Union Trust Bldg., Pittsburgh, Pa.
Farm H. & D. Thompson Acres 102
Location (waters) (Harry D. Fairry)
Well No. 2742 Elev. _____
District McElroy County Tyler
The surface of tract is owned in fee by Gertrude Thompson
R.D.1 - Box 130-D Address Yorba Linda, Calif.
Mineral rights are owned by The Mfrs. Light & Heat Co.
800 Union Trust Bldg. Address Pittsburgh, Pa.
Drilling commenced July 15th, 1922
Drilling completed September 18th, 1922
Date Shot _____ From _____ To _____
With _____

Casing and Tubing	Used in Drilling	Left in Well	Packers
Size			
16			Kind of Packer
13			
10	220' 1"		Size of
8 3/4	1259' 0"		
6 3/8	1950'		Depth set
5 3/16			
3			Perf. top
2			Perf. bottom
Liners Used			Perf. top
			Perf. bottom


Open Flow _____ /10ths Water in _____ Inch
_____ /10ths Merc. in _____ Inch
Volume _____ Cu. Ft.
Rock Pressure _____ lbs _____ hrs.
Oil _____ bbls., 1st 24 hrs.
Fresh water _____ feet _____ feet
Salt water _____ feet _____ feet

CASING CEMENTED _____ SIZE _____ No. Ft. _____ Date _____

COAL WAS ENCOUNTERED AT 696 FEET 24 INCHES
_____ FEET _____ INCHES _____ FEET _____ INCHES
_____ FEET _____ INCHES _____ FEET _____ INCHES

Formation	Color	Hard or Soft	Top	Bottom	Oil, Gas or Water	Depth Found	Remarks
Clay			0	50			
Sand			50	100			
Slate			100	150			
Lime & Slate			150	250			
Clay			250	350			
Slate & Shells			350	457			
Native Coal			457	460			
Lime			460	560			
Slate			560	660			
Sand			660	696			
Pittsburgh Coal			696	698			
Red Rock			698	798			
Sand			798	898			
Clay			898	998			
Slate & Lime			998	1098			
Lime			1098	1155			
Big Dunkard			1155	1170			
Slate			1170	1250			
Gas Sand			1250	1261			
Slate			1261	1312			
1st. Salt Sand			1312	1362			
Slate			1362	1455			
2nd. Salt Sand			1455	1520			
Slate			1520	1615			
Lime			1615	1640			
Slate			1640	1660			
Slate			1660	1798			
Maxon Sand			1798	1828			
Lime			1828	1840			
Red Rock			1840	1860			
Slate			1860	1871			
Little Lime			1871	1886			
Pencil Cave			1886	1898			
Blue Monday			1898	1944			
Big Lime			1944	1996			
Big Injun			1996				
Gas at			2002	2008			
TOTAL DEPTH			2036				

Water at 1510' - 4 bailers per. hr.

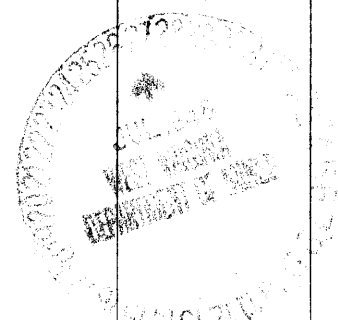

Formation	Color	Hard or Soft	Top	Bottom	Oil, Gas or Water	Depth Found	Remarks

Date July 26th, 194 8

APPROVED THE MANUFACTURERS LIGHT & HEAT COMPANY, Owner

By *Paul Cooper*
(Title) LAND AGENT.

