

Surface = Lester Leasure.
Coal = Not Marketable

4.90 S
0.36 W

New Location
Drill Deeper
Abandonment

Company A. M. Snider
Address Hundred W. Va.
Farm John Wright
Tract 1 Acres 73+ Lease No. SE
Well (Farm) No. 1 Serial No. SE
Elevation (Spirit Level) 1056'
Quadrangle New Martinsville
County Tyler District Ellsworth
Engineer A. L. Headley
Engineer's Registration No. _____
File No. _____ Drawing No. _____
Date 9-6-1948 Scale 1" = 500

STATE OF WEST VIRGINIA
DEPARTMENT OF MINES
OIL AND GAS DIVISION
CHARLESTON

WELL LOCATION MAP
FILE NO. JYL-516-A

+ Denotes location of well on United States Topographic Maps, scale 1 to 62,500, latitude and longitude lines being represented by border lines as shown.
- Denotes one inch spaces on border line of original tracing.



STATE OF WEST VIRGINIA
DEPARTMENT OF MINES
OIL AND GAS DIVISION

474

WELL RECORD

Permit No. 516-A

Oil or Gas Well _____ (KIND)

Company A. M. Snider
Address Hundred, West Virginia
Farm John Wright Acres 73
Location (waters) Branch of Daniels Run
Well No. 1 Elev. 1056
District Ellsworth County Tyler
The surface of tract is owned in fee by _____
Address _____
Mineral rights are owned by _____
Address _____

Drilling commenced May 16, 1911
Drilling completed Aug. 1, 1911
Date Shot No Record From _____ To _____
With _____


Open Flow _____ /10ths Water in _____ Inch
_____ /10ths Merc. in _____ Inch
Volume _____ Cu. Ft.
Rock Pressure _____ lbs. _____ hrs.
Oil _____ bbls., 1st 24 hrs.
Fresh water _____ feet _____ feet
Salt water 1690 2084-96 feet _____ feet

Casing and Tubing	Used in Drilling	Left in Well	Packers
Size			
16			Kind of Packer _____
13			
10	<u>242</u>	<u>Pulled</u>	Size of _____
8 1/4	<u>1230</u>	<u>Pulled</u>	Depth set _____
6 5/8	<u>1965'10"</u>	<u>1965'10"</u>	
5 3/16	<u>2117</u>	<u>2117</u>	
3			Perf. top _____
2	<u>2846'3"</u>	<u>2846'3"</u>	Perf. bottom _____
Liners Used			Perf. top _____
			Perf. bottom _____

CASING CEMENTED _____ SIZE _____ No. Ft. _____ Date _____

COAL WAS ENCOUNTERED AT 706 FEET 36 INCHES
_____ FEET _____ INCHES FEET _____ INCHES
_____ FEET _____ INCHES FEET _____ INCHES

Formation	Color	Hard or Soft	Top	Bottom	Oil, Gas or Water	Depth Found	Remarks
Pittsburgh Coal			706	709			
Dunkard Sand			1053	1211			
Salt Sand			1492	1747	Water	1690	
Injun Sand			1979	2146	"	2084-96	
Berea Sand			2247	2270			
Gantz Sand			2344	2397			
Fifty Foot			2528	2554			
Thirty Foot			2674	2693			
Stray Sand			2750	2762			
Gordon Sand			2771	2811	Gas	2776	
					Gas	2791	
					Gas	2802	
Total Depth				2827			

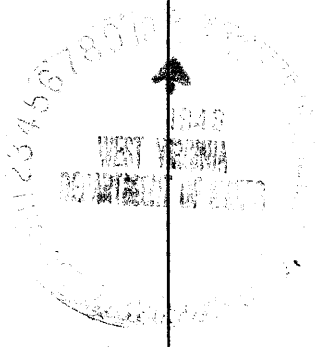

JOHN WRIGHT NO. 1 WELL.

Ellsworth District, Tyler County, W. Va. 572
 By A. M. Snider, Hundred, W. Va.
 Abandoned under permit Tyl-.....-A?
 On 73 acres, on branch of Daniels Run.
 Elevation, 1056' L.
 Drilling commenced May 16, 1911; completed Aug. 1, 1911.
 Date shot, no record.
 Salt water at 1690 and 2084-96'.
 10" casing, 242' (pulled); 8 $\frac{1}{4}$ " , 1230' (pulled); 6 $\frac{5}{8}$ " , 1965' 10";
 5 $\frac{3}{16}$ " , 2117'; 2" tubing, 2846' 3".
 Coal was encountered at 706-709'.
 Gas well. Record to Dept. of Mines stamped.....11, 1948.
 Record to RCT from Mrs. Griffith Feb. 3, 1949. Old File No. 474.

	Top.	Bottom.
Pittsburgh Coal	706	- 709
Dunkard Sand	1053	- 1211
Salt Sand (water, 1690')	1492	- 1747
Big Injun Sand (water, 2084-96')	1979	- 2146
Berea Sand	2247	- 2270
Gantz Sand	2344	- 2397
Fifty-foot Sand	2528	- 2554
Thirty-foot Sand	2674	- 2693
Stray Sand	2750	- 2762
Gordon Sand (gas, 2776, 2791, and 2802')	2771	- 2811
Total depth		2827