

New Location..   
 Drill Deeper.....   
 Abandonment.....

(Elev casing head 617.51')

Company Roy W. Confer Co.  
 Address 515 Allen St., Titusville, Pa.  
 Farm Eph Wells  
 Tract 1 Acres 4.52 Lease No. 6078  
 Well (Farm) No. 21 Serial No. \_\_\_\_\_  
 Elevation (Spirit Level) 613.4'  
 Quadrangle New Matamoras **SE**  
 County Tyler District Lincoln  
 Engineer Don L. Riggle  
 Approved by George R. Clarke  
 Engineer's Registration No. 102  
 File No. 046-5L.12 Drawing No. 1427  
 Date 7-28-48 Scale 1" = 60 ft

STATE OF WEST VIRGINIA  
 DEPARTMENT OF MINES  
 OIL AND GAS DIVISION  
 CHARLESTON

**WELL LOCATION MAP**  
 FILE NO. JYL-517-A

+ Denotes location of well on United States Topographic Maps, scale 1 to 62,500, latitude and longitude lines being represented by border lines as shown.

- Denotes one inch spaces on border line of original tracing.



STATE OF WEST VIRGINIA  
DEPARTMENT OF MINES  
OIL AND GAS DIVISION

500

WELL RECORD

Permit No. 517-A

Oil or Gas Well OIL  
(KIND)


Company Roy W. Confer  
Address 515 Allen St., Titusville, Pa.  
Farm Eph Wells Acres 452  
Location (waters) \_\_\_\_\_  
Well No. 21 Elev. 613.4  
District Lincoln County Tyler  
The surface of tract is owned in fee by F. R. Wells  
Address Sistersville, W. Va.  
Mineral rights are owned by South Penn Oil Co.  
Address Parkersburg, W. Va.

| Casing and Tubing  | Used in Drilling | Left in Well | Packers        |
|--------------------|------------------|--------------|----------------|
| Size               |                  |              | Kind of Packer |
| 16                 |                  |              |                |
| 13                 |                  |              |                |
| 10                 | 63               |              | Size of        |
| <del>8</del> 8 1/4 | 230              |              |                |
| 6 1/4              | 1035             |              | Depth set      |
| 5 3/16             |                  |              |                |
| 4-7/8              | 751              |              | Perf. top      |
| 2                  | 1427             |              | Perf. bottom   |
| Liners Used        |                  |              | Perf. top      |
|                    |                  |              | Perf. bottom   |

Drilling commenced \_\_\_\_\_  
Drilling completed \_\_\_\_\_  
Date Shot 10-9-94 From \_\_\_\_\_ To No record  
With \_\_\_\_\_  
Open Flow \_\_\_\_\_ /10ths Water in \_\_\_\_\_ Inch  
\_\_\_\_\_ /10ths Merc. in \_\_\_\_\_ Inch  
Volume \_\_\_\_\_ Cu. Ft.  
Rock Pressure \_\_\_\_\_ lbs. \_\_\_\_\_ hrs.  
Oil No record bbls., 1st 24 hrs.  
Fresh water \_\_\_\_\_ feet \_\_\_\_\_ feet  
Salt water \_\_\_\_\_ feet \_\_\_\_\_ feet

CASING CEMENTED \_\_\_\_\_ SIZE \_\_\_\_\_ No. Ft. \_\_\_\_\_ Date \_\_\_\_\_  
COAL WAS ENCOUNTERED AT \_\_\_\_\_ FEET \_\_\_\_\_ INCHES  
\_\_\_\_\_ FEET \_\_\_\_\_ INCHES FEET \_\_\_\_\_ INCHES  
\_\_\_\_\_ FEET \_\_\_\_\_ INCHES FEET \_\_\_\_\_ INCHES

| Formation | Color | Hard or Soft | Top  | Bottom | Oil, Gas or Water | Depth Found | Remarks |
|-----------|-------|--------------|------|--------|-------------------|-------------|---------|
| Big Injun |       |              | 1387 | 1427   | Oil               | 1387        |         |

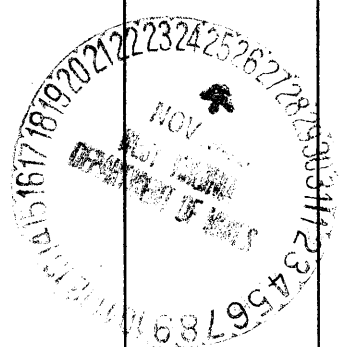

EPH WELLS NO. 21 WELL.

Lincoln District, Tyler County, W. Va.  
By Roy W. Confer, 515 Allen St., Titusville, Pa.  
Abandoned under permit Tyl-.....-A?

On 452 acres.

Elevation, 613.4' L.

Surface owned by F. R. Wells, Sistersville, W. Va., and minerals by  
South Penn Oil Co., Parkersburg, W. Va.

Shot Oct. 9, 1894.

10" casing, 63'; 8 $\frac{1}{4}$ " , 230'; 6 $\frac{1}{4}$ " , 1035'; 4-7/8" , 751'; 2" tubing, 1427'.

Oil well. Record to Dept. of Mines stamped Nov. 26, 1948.

Record to RCT from Mrs. Griffith Jan. 5, 1949. Old File No. 460.

Big Injun Sand (oil, 1387')

Total depth

Top. Bottom.

1387 - 1427

1427'