

Company Roy W. Confer Co.
 Address 515 Allen St., Titusville, Pa.
 Farm S. O. Anshuts
 Tract 1 Acres 191 Lease No. 6136
 Well (Farm) No's 6, 16 & 17 Serial No. No. 6 - 630,25
 Elevation (Spirit Level) No. 16 - 797.7 No. 17 - 623.34'
 Quadrangle New Matamoras
 County Tyler District Union SE
 Engineer Don L. Riggle
 Approved by George R. Clarke
 Engineer's Registration No. 102
 File No. 0+G-54-11 Drawing No. 1429
 Date 7-28-'48 Scale 1" = 60'

STATE OF WEST VIRGINIA
 DEPARTMENT OF MINES
 OIL AND GAS DIVISION
 CHARLESTON

WELL LOCATION MAP
 JYL-522-A-#6
 FILE NO. JYL-523-A-#16
 JYL-524-A-#17

+ Denotes location of well on United States Topographic Maps, scale 1 to 62,500, latitude and longitude lines being represented by border lines as shown.

- Denotes one inch spaces on border line of original tracing.



508

STATE OF WEST VIRGINIA
DEPARTMENT OF MINES
OIL AND GAS DIVISION

COPY

WELL RECORD

Permit No. 5000-A

Oil or Gas Well Oil
(KIND)


Company Roy W. Confer Co.
Address 515 Allen St., Titusville, Pa.
Farm S. O. Anshutz Acres 191
Location (waters) _____
Well No. 6 Elev. 630.25
District Union County Tyler
The surface of tract is owned in fee by F. R. Wells
Address _____
Mineral rights are owned by South Penn Oil Co
Address Parkersburg, W. Va.

Casing and Tubing	Used in Drilling	Left in Well	Packers
Size			Kind of Packer
16			
13			
10	50' Could not be	at well	located
8 1/4	230' Pulled Out		Size of
6 1/4	970'		Depth set
5 3/16			
3			Perf. top
2			Perf. bottom
Liners Used			Perf. top
			Perf. bottom

Drilling commenced _____
Drilling completed _____
Date Shod Dec. 1894 From No Record To No Record
With 20 qts
Open Flow /10ths Water in _____ Inch
/10ths Merc. in _____ Inch
Volume _____ Cu. Ft.
Rock Pressure _____ lbs. _____ hrs.
Oil No Record _____ bbls., 1st 24 hrs.
Fresh water _____ feet _____ feet
Salt water _____ feet _____ feet

CASING CEMENTED _____ SIZE _____ No. Ft. _____ Date _____
COAL WAS ENCOUNTERED AT _____ FEET _____ INCHES
_____ FEET _____ INCHES _____ FEET _____ INCHES
_____ FEET _____ INCHES _____ FEET _____ INCHES

Formation	Color	Hard or Soft	Top	Bottom	Oil, Gas or Water	Depth Found	Remarks
Big Injun			1374	1415	Oil	1374	

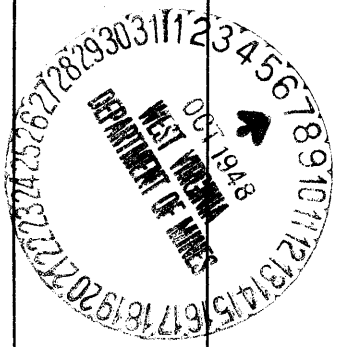

(Over)

AUG 1 0 1949