

Surface, Coal, Oil & Gas: Dorsey Baker Hrs. et al.
 Address J.A. Baker, Alvy, Tyler Co., W.Va.

1- 4.82 S 1.57 W # 5- 4.86 S 1.77 W # 6- 4.59 S 1.83 W

New Location...
 Drill Deeper...
 Abandonment...

On 800' map N 47 S 1-2 W A-5

Company Cassady & Mackey
 Address Star Route West Union W.Va.
 Farm Dorsey Baker
 Tract _____ Acres 150 Lease No. _____
 Well (Farm) No. 1546 Serial No. _____
 Elevation (Spirit Level) see above at wells
 Quadrangle CENTERPOINT
 County Tyler District McElroy
Doddridge McClellan
 Engineer E.C. Tabler
 Engineer's Registration No. _____
 File No. _____ Drawing No. _____
 Date Sept 13th 1948 Scale 1" = 800 feet.

STATE OF WEST VIRGINIA
 DEPARTMENT OF MINES
 OIL AND GAS DIVISION
 CHARLESTON

WELL LOCATION MAP
 DOD-697-A-#1
 FILE NO. ~~DOD-698-A-#5~~
 JYL-525-A-#6

+ Denotes location of well on United States Topographic Maps, scale 1 to 62,500, latitude and longitude lines being represented by border lines as shown.
 - Denotes one inch spaces on border line of original tracing.



STATE OF WEST VIRGINIA
DEPARTMENT OF MINES
OIL AND GAS DIVISION

WELL RECORD

Permit No. _____

Oil or Gas Well _____ (KIND)


Company **Cassady & Mackey**
Address **West Union, W. Va.**
Farm **Dorsey Baker** Acres **150**
Location (waters) _____
Well No. **6** Elev. **1027.57**
District **McClellan & McElroy** County **Doddridge & Tyler**
The surface of tract is owned in fee by **Dorsey Baker et.al**
Address _____
Mineral rights are owned by **Dorsey Baker et.al**
J. A. Baker Address **Alvy, W. Va.**

Drilling commenced _____
Drilling completed **8/3/11**
Date Shot _____ From **2894** To **2932**
With **100 Qt**
Open Flow _____ /10ths Water in _____ Inch
_____ /10ths Merc. in _____ Inch
Volume _____ Cu. Ft.
Rock Pressure _____ lbs. _____ hrs.
Oil _____ bbls., 1st 24 hrs.
Fresh water _____ feet _____ feet
Salt water _____ feet _____ feet

Casing and Tubing	Used in Drilling	Left in Well	Packers
Size			
16			Kind of Packer
10	309	309	Size of
8 1/4	1369	906	
6%	2286	2286	Depth set
5 3/16	2370	2370	
3			Perf. top
2			Perf. bottom
Liners Used			Perf. top
			Perf. bottom

CASING CEMENTED _____ SIZE _____ No. Ft. _____ Date _____
COAL WAS ENCOUNTERED AT _____ FEET _____ INCHES
_____ FEET _____ INCHES FEET _____ INCHES
_____ FEET _____ INCHES FEET _____ INCHES

Formation	Color	Hard or Soft	Top	Bottom	Oil, Gas or Water	Depth Found	Remarks
Pittsburgh Coal				802			
Big injun Sand			2172	2300			
Stray			2860	2878			
Gordon			2878	2896	Oil	2890	
Total Depth				2932			

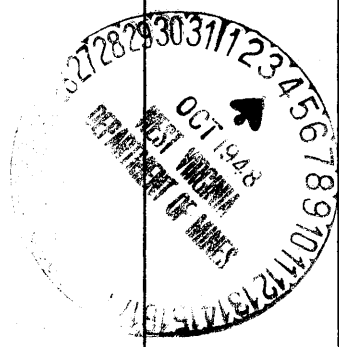

DORSEY BAKER NO. 6 WELL.

Tyler 7525A

McClellan District, Doddridge County, and McElroy District, Tyler Co., W. Va.
By Cassady & Mackey, West Union, W. Va.

Abandoned under permit Dod-.....-A? (Tyl-.....-A?)

On 150 acres.

Elevation, 1027.57' L.

Surface owned by Dorsey Baker et al., and minerals by Dorsey Baker et al.,
J. A. Baker, Alvy, W. Va.

Drilling completed Aug. 3, 1911.

Shot at 2894-2932', with 100 qts.

10" casing, 309'; 8 $\frac{1}{4}$ "", 1369' (906' left in); 6 $\frac{5}{8}$ "", 2286'; 5 $\frac{3}{16}$ "", 2370'.

Oil well. Record to Dept. of Mines stamped Oct. 4, 1948.

Record to RCT from Mrs. Griffith Jan. 5, 1949. Old File No. 574.

	Top.	Bottom.
Pittsburgh Coal		812
Big Injun Sand	2172 -	2300
Stray Sand	2860 -	2878
Gordon Sand (oil, 2890')	2878 -	2896
Total depth		2932