

Surface: A.J. Walters Hrs. & Emma L. Walters  
 Address Mrs. Emma L. Walters, 190 Russell Ave., Akron Ohio.  
 No Commercial Coal; if any, it belongs to the owners of the surface.

New Location...   
 Drill Deeper.....   
 Abandonment.....

On 800' Map # N 47 M 1-2 W 4

Company Cassady & Mackey  
 Address Star Route West Union W Va  
 Farm A.D. Lemasters  
 Tract \_\_\_\_\_ Acres 78 Lease No. \_\_\_\_\_  
 Well (Farm) No. 3 Serial No. \_\_\_\_\_  
 Elevation (Spirit Level) Floor - 1144.97  
Ground - 1140.72  
 Quadrangle CENTER POINT  
 County Tyler District MCELOY  
 Engineer Ernest C. Tabler  
 Engineer's Registration No. 2005  
 File No. Sept 20<sup>th</sup> Drawing No. \_\_\_\_\_  
 Date 5 Scale 1" = 800 Feet.

STATE OF WEST VIRGINIA  
 DEPARTMENT OF MINES  
 OIL AND GAS DIVISION  
 CHARLESTON

WELL LOCATION MAP  
 FILE NO. JYL-532-A

+ Denotes location of well on United States Topographic Maps, scale 1 to 62,500, latitude and longitude lines being represented by border lines as shown.

- Denotes one inch spaces on border line of original tracing.



STATE OF WEST VIRGINIA  
DEPARTMENT OF MINES  
OIL AND GAS DIVISION

518

WELL RECORD

Oil or Gas Well Oil  
(KIND)

Permit No. AB 530-A


Company Cassady & Mackey  
Address Star Rt. West Union, W. Va.  
Farm A. D. Lemasters Acres 78  
Location (waters) Indian Creek  
Well No. 3 Elev. 1140.72  
District McElroy County Tyler  
The surface of tract is owned in fee by Ema L. Waters  
Address 190 Russell Ave  
Mineral rights are owned by Akron Ohio  
Address \_\_\_\_\_

Drilling commenced \_\_\_\_\_  
Drilling completed \_\_\_\_\_  
Date Shot 3/28/28 From 3034 To 3035  
With 30 qts  
Open Flow /10ths Water in \_\_\_\_\_ Inch  
/10ths Merc. in \_\_\_\_\_ Inch  
Volume \_\_\_\_\_ Cu. Ft.  
Rock Pressure \_\_\_\_\_ lbs. \_\_\_\_\_ hrs.  
Oil \_\_\_\_\_ bbls., 1st 24 hrs.  
Fresh water \_\_\_\_\_ feet \_\_\_\_\_ feet  
Salt water \_\_\_\_\_ feet \_\_\_\_\_ feet

Casing and Tubing	Used in Drilling	Left in Well	Packers
Size			
16			Kind of Packer
13			
10	269	0	Size of
8 1/4	1189	1189	
6 3/4	1977	1977	Depth set
5 3/16	2426	2426	
3			Perf. top
2	3046	3046	Perf. bottom
Liners Used			Perf. top
			Perf. bottom

CASING CEMENTED \_\_\_\_\_ SIZE \_\_\_\_\_ No. Ft. \_\_\_\_\_ Date \_\_\_\_\_  
COAL WAS ENCOUNTERED AT \_\_\_\_\_ FEET \_\_\_\_\_ INCHES  
\_\_\_\_\_ FEET \_\_\_\_\_ INCHES FEET \_\_\_\_\_ INCHES  
\_\_\_\_\_ FEET \_\_\_\_\_ INCHES FEET \_\_\_\_\_ INCHES

Formation	Color	Hard or Soft	Top	Bottom	Oil, Gas or Water	Depth Found	Remarks
Pittsburgh Coal			947	950			
Big Injun			2250	2380			
Stray			2990	3017			
Gordon			3020	3035	oil	3023 3034	
Total Depth				3050			

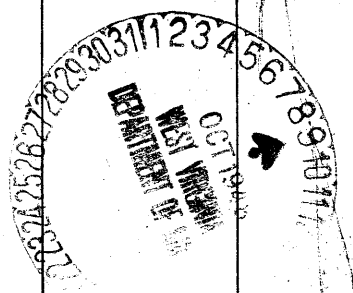

SEP 14 1949

(Over)

