


4	0.61	S
	3.37	W
3	0.67	S
	3.74	W
6	0.69	S
	3.40	W
2	0.68	S
	3.11	W

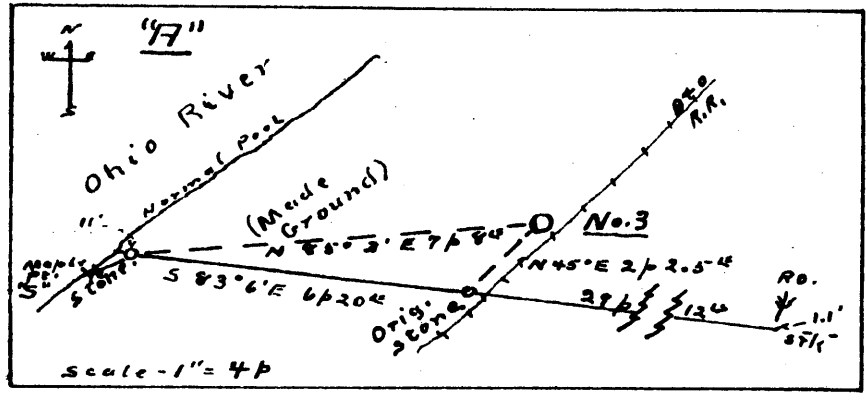

New Location...

Drill Deeper.....

Abandonment.....

Casing heads:-  
 No. 3 + 0.2'    No. 6 + 1.5'  
 No. 4 + 1'    No. 12 + 3'  
 (No. 3 Well has previously been located on 1924 Topo. Sheet.)

Company Roy W. Confer Co.

Address 515 Allen St. Titusville, Pa.

Farm E. P. Russell

Tract 1 Acres 60 Lease No. \_\_\_\_\_

Well (Farm) No. 3, 4, 6 & 12 Serial No. 3-529,021/6-1029,836

Elevation (Spirit Level) 4-1062.506/2-900.031

Quadrangle New Martinsville

County Tyler District Lincoln

Engineer Don L. Riggle SW

Engineer's Registration No. \_\_\_\_\_

File No. 0+G-S.P. 11 Drawing No. \_\_\_\_\_

Date Apr. 28, 48 Scale 1" = 60 p

STATE OF WEST VIRGINIA  
 DEPARTMENT OF MINES  
 OIL AND GAS DIVISION  
 CHARLESTON

**WELL LOCATION MAP**

FILE NO. JYL-542-A-#4  
JYL-545-A-#12 JYL-543-A-#3  
JYL-544-A-#6

+ Denotes location of well on United States Topographic Maps, scale 1 to 62,500, latitude and longitude lines being represented by border lines as shown.

- Denotes one inch spaces on border line of original tracing.

E. RUSSELL HEIRS NO. 3 WELL.

Lincoln District, Tyler County, W. Va.

By St. Marys Pipe & Supply Co., Box 21, St. Marys, W. Va.

Abandoned under permit Tyl-<sup>543</sup>---AT

On.....acres.

Elevation, .....' L.

Surface and minerals owned by E. Miller Heirs, Sistersville, W. Va.

Drilling commenced and completed in 1897.

Shot Feb. 1897, with 60 qts. nitroglycerine.

No water.

10" casing, 90' (pulled); 7 1/2", 900' (pulled); 6 1/2", 1200'.

No coal logged.

Oil well. Record to Dept. of Mines stamped Feb. 1, 1952.

Record to DOT from Mrs. Griffith Dec. 2, 1952. O.F.No.675.

Sand (oil, 1808')

Total depth

Top. Bottom.

1808 - 1839

1839