

#12	0.81	S
	3.81	W
#5	0.73	S
	3.48	W
#15	0.50	S
	3.79	W
#16	0.74	S
	4.11	W

Surface owned by Wm. & Laura A. Smith.  
 Address: Mr. Wm. Smith, Shirley, Tyler Co. W. Va.  
 No Coal ever sold under this tract, if any, it belongs to the owner of the Surface.

New Location   
 Drill Deeper   
 Abandonment  On 800' Map Sheet N47. Sqs. S 3-4 W 6-7.

Company Randall-Zogg Supply Co.  
 Address Owensboro, Ky.  
 Farm David Underwood  
 Tract \_\_\_\_\_ Acres 247 Lease No. INC  
 Well (Farm) Nos. 5, 12, 15, & 16. Serial No. \_\_\_\_\_  
 Elevation (Spirit Level) See Wells above for Elev.  
 Quadrangle Centerpoint  
 County Tyler District McElroy  
 Engineer A. L. Headley  
 Engineer's Registration No. 2021  
 File No. \_\_\_\_\_ Drawing No. \_\_\_\_\_  
 Date Feb. 18th, 1949. Scale 1" = 800 Feet

STATE OF WEST VIRGINIA  
 DEPARTMENT OF MINES  
 OIL AND GAS DIVISION  
 CHARLESTON

**WELL LOCATION MAP**  
 JYL-573-A-#12  
 FILE NO. JYL-574-A-#5  
 JYL-576-A-#15  
 JYL-577-A-#16

+ Denotes location of well on United States Topographic Maps, scale 1 to 62,500, latitude and longitude lines being represented by border lines as shown.

- Denotes one inch spaces on border line of original tracing.



514

STATE OF WEST VIRGINIA  
DEPARTMENT OF MINES  
OIL AND GAS DIVISION

WELL RECORD

Permit No. 77-A

Oil or Gas Well OIL  
(KIND)


Company RANDALL-ZOGG SUPPLY COMPANY  
 Address BOX 526, CHARLESTON, 22 W. VA.  
 Farm David Underwood Acres 247  
 Location (waters) Davis Run  
 Well No. Sixteen (16) Elev. 267.85  
 District McElroy County Tyler  
 The surface of tract is owned in fee by Wm. & Laura A. Smith  
 Address Shirley, W. Va.  
 Mineral rights are owned by Wm. & Laura A. Smith,  
 Address Shirley, W. Va.  
 Drilling commenced \_\_\_\_\_  
 Drilling completed \_\_\_\_\_  
 Date Shot SEE BELOW From \_\_\_\_\_ To \_\_\_\_\_  
 With \_\_\_\_\_

Casing and Tubing	Used in Drilling	Left in Well	Packers
Size			Kind of Packer
16			
13			
10	<u>309'</u>		Size of
8 3/4	<u>1194'</u>		
6 5/8	<u>2010'</u>	<u>1020'</u>	Depth set
5 3/16	<u>2014'</u>	<u>2014'</u>	
3 1/2"	<u>200'</u>	<u>200'</u>	Perf. top
2	<u>2102'</u>	<u>2102'</u>	Perf. bottom
Liners Used			Perf. top
			Perf. bottom

Open Flow /10ths Water in \_\_\_\_\_ Inch  
 /10ths Merc. in \_\_\_\_\_ Inch  
 Volume \_\_\_\_\_ Cu. Ft.  
 Rock Pressure \_\_\_\_\_ lbs. \_\_\_\_\_ hrs.  
 Oil \_\_\_\_\_ bbls., 1st 24 hrs.  
 Fresh water \_\_\_\_\_ feet \_\_\_\_\_ feet  
 Salt water \_\_\_\_\_ feet \_\_\_\_\_ feet

CASING CEMENTED \_\_\_\_\_ SIZE \_\_\_\_\_ No. Ft. \_\_\_\_\_ Date \_\_\_\_\_  
 COAL WAS ENCOUNTERED AT 667 FEET \_\_\_\_\_ INCHES  
 \_\_\_\_\_ FEET \_\_\_\_\_ INCHES FEET \_\_\_\_\_ INCHES  
 \_\_\_\_\_ FEET \_\_\_\_\_ INCHES FEET \_\_\_\_\_ INCHES

Formation	Color	Hard or Soft	Top	Bottom	Oil, Gas or Water	Depth Found	Remarks
Pittsburgh Coal			<u>667'</u>				
Big Injun Sand			<u>1990'</u>		<u>Oil</u>	<u>2071'</u>	
Total Depth			<u>2102'</u>				
<b>SHOT RECORD</b>							
	<u>DATE SHOT</u>		<u>NO. QTS.</u>		<u>TOP OF SHOT</u>		
	<u>10-11-02</u>		<u>40</u>		<u>2069'</u>		
	<u>5-23-09</u>		<u>24</u>		<u>2071'</u>		

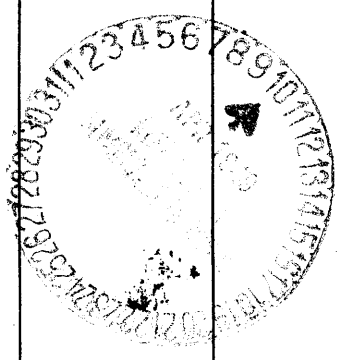

Formation	Color	Hard or Soft	Top	Bottom	Oil, Gas or Water	Depth Found	Remarks

Date April 6th, 1949

APPROVED RANDALL-ZOGG SUPPLY COMPANY, Owner

By [Signature]  
(Title) Agent