

#6728	5.03	S
	4.41	W
#6700	5.00	S
	4.33	W
#7180	5.03	S
	4.28	W

New Location
 Drill Deeper
 Abandonment 6728

Map Sh. 53 Sq. S1-2 W7 FB. 665 P-37

Company Hope Natural Gas Co.
 Address Clarksburg, W. Va.
 Farm Hannah Merritt
 Tract _____ Acres 74 Lease No. 33994
 Well (Farm) No. _____ Serial No. As Shown
 Elevation (Spirit Level) As Shown
 Quadrangle Centerpoint
 County Tyler District MSEIroy
 Engineer W.M. Bowers
 Engineer's Registration No. 900
 File No. _____ Drawing No. _____
 Date 8-1-46 Scale 1" = 40P

STATE OF WEST VIRGINIA
 DEPARTMENT OF MINES
 OIL AND GAS DIVISION
 CHARLESTON

WELL LOCATION MAP
 FILE NO. TYL-462-A-NA6728
594 + 596

+ Denotes location of well on United States Topographic Maps, scale 1 to 62,500, latitude and longitude lines being represented by border lines as shown.

- Denotes one inch spaces on border line of original tracing.



STATE OF WEST VIRGINIA
DEPARTMENT OF MINES
OIL AND GAS DIVISION

537

WELL RECORD

Permit No. 596A

~~Oil~~ Gas Well (KIND)

Company Hope Natural Gas Company.
Address 445 West Main St. Clarksburg, W. Va.
Farm Hannah Merritt Acres 74
Location (waters) _____
Well No. 7180 Elev. 1122
District McElroy County Tyler
The surface of tract is owned in fee by _____
Address _____
Mineral rights are owned by _____
Address _____
Drilling commenced September 21, 1927
Drilling completed October 28, 1927
Date Shot _____ From _____ To _____
With _____


Casing and Tubing	Used in Drilling	Left in Well	Packers
Size			Kind of Packer
16			
13			
10	<u>542</u>	<u>Pulled</u>	Size of
8 3/4	<u>1627</u>	<u>1595</u>	
6 3/4	<u>2064</u>	<u>2064</u>	Depth set
5 3/16			
3			Perf. top
2			Perf. bottom
Liners Used			Perf. top
			Perf. bottom

Open Flow _____ /10ths Water in _____ Inch
_____ /10ths Merc. in _____ Inch
Volume _____ Cu. Ft.
Rock Pressure _____ lbs. _____ hrs.
Oil _____ bbls., 1st 24 hrs.
Fresh water _____ feet _____ feet
Salt water 1590 feet _____ feet


~~NOT~~
CASING CEMENTED _____ SIZE _____ No. Ft. _____ Date _____

COAL WAS ENCOUNTERED AT 785 FEET 36 INCHES
_____ FEET _____ INCHES _____ FEET _____ INCHES
_____ FEET _____ INCHES _____ FEET _____ INCHES

Formation	Color	Hard or Soft	Top	Bottom	Oil, Gas or Water	Depth Found	Remarks
Pittsburgh Coal			785	788			
Big Dunkard			1230	1250			
Gas sand			1285	1300			
First Salt			1380	1492			
Second Salt			1550	1630	water	1590	
Third Salt			1770	1820	water	1780	
Maxon			1918	1959	oil	1951	
Little Lime			2002	2012			
Pencil cave			2012	2025			
knickknack							
Big Lime			2025	2093			
Big Injun			2093		gas	2114 2200	
Total depth				2233			

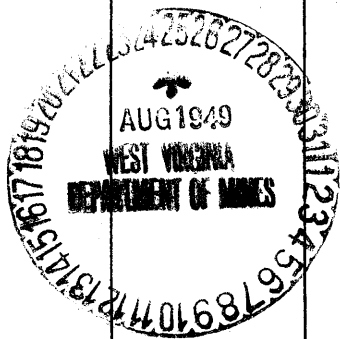

Formation	Color	Hard or Soft	Top	Bottom	Oil, Gas or Water	Depth Found	Remarks

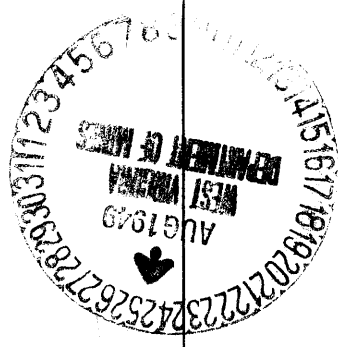

Date August 23, 1949, 19

APPROVED Hope Natural Gas Company., Owner

By _____ (Title)