

New Location
 Drill Deeper
 Abandonment

Company J.R. Bull
 Address Sistersville, W. Va.
 Farm J.M. Dare
 Tract 1 Acres 40 Lease No. 6082
 Well (Farm) No. 1+5 Serial No. _____
 Elevation (Spirit Level) 1-740' 5-702'
 Quadrangle New Martinsville
 County Tyler District Lincoln
 Engineer Don L. Riggle
 Approved by George R. Clark
 Engineer's Registration No. 102
 File No. 046-S.P.11 Drawing No. 1399
 Date May 20, '48 Scale 1" = 300'

STATE OF WEST VIRGINIA
 DEPARTMENT OF MINES
 OIL AND GAS DIVISION
 CHARLESTON

WELL LOCATION MAP

FILE NO. TYL-624-A-5
TYL-625-A-1

+ Denotes location of well on United States Topographic Maps, scale 1 to 62,500, latitude and longitude lines being represented by border lines as shown.

- Denotes one inch spaces on border line of original tracing.



STATE OF WEST VIRGINIA
DEPARTMENT OF MINES
OIL AND GAS DIVISION

566

WELL RECORD

Permit No. 9225 A

Oil or Gas Well Oil
(KIND)


Company Maurice Horowitz
Address 310 N. McKean St., Butler, Penna.
Farm J. M. Dare Acres _____
Location (waters) _____
Well No. 1 Elev. _____
District Lincoln County Tyler
The surface of tract is owned in fee by _____
Address _____
Mineral rights are owned by _____
Address _____
Drilling commenced _____
Drilling completed _____
Date Shot _____ From _____ To _____
With _____
Open Flow _____ /10ths Water in _____ Inch
_____ /10ths Merc. in _____ Inch
Volume _____ Cu. Ft.
Rock Pressure _____ lbs. _____ hrs.
Oil _____ bbls., 1st 24 hrs.
Fresh water _____ feet _____ feet
Salt water _____ feet _____ feet

Casing and Tubing	Used in Drilling	Left in Well	Packers
Size			Kind of Packer
16			
13			
10	90'	90'	Size of
8 1/4	850'	700'	
6 5/8	1165'	1165'	Depth set
5 3/16			
3			Perf. top
2			Perf. bottom
Liners Used			Perf. top
			Perf. bottom

CASING CEMENTED _____ SIZE _____ No. Ft. _____ Date _____

COAL WAS ENCOUNTERED AT _____ FEET _____ INCHES
_____ FEET _____ INCHES _____ FEET _____ INCHES
_____ FEET _____ INCHES _____ FEET _____ INCHES

Formation	Color	Hard or Soft	Top	Bottom	Oil, Gas or Water	Depth Found	Remarks
Big Injun			1528'	1594'			All the record shows

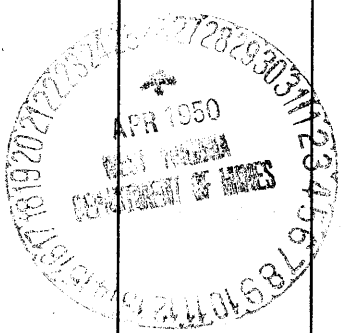

NOV 18 1950