


Latitude 39° 35'

Longitude 80° 55'

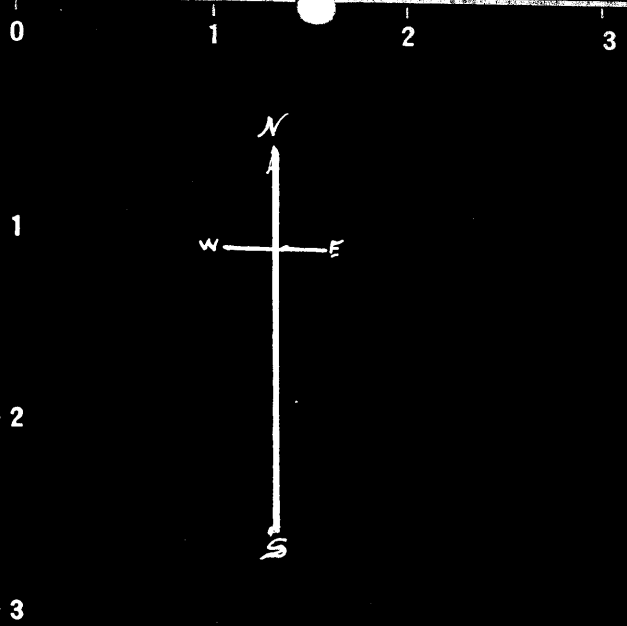

#2	W 334
627-A	S 1.07
#5	W 343
628-A	S 1.02
#7	W 319
629-A	S 1.07
#9	W 306

+++
+

Reno Oil Co. Fork of Pole Cat Run



630-A	S 1.22
#12	W 3.20
634-A	S 1.10
#13	W 3.26

- TYL-626-A - 2
- TYL-627-A - 5
- TYL-628-A - 7
- TYL-629-A - 9
- TYL-630-A - 12
- TYL-631-A - 13

Company J. R. Bull
 Address Sistersville, W. Va.
 Farm J. R. Dunfee
 Tract 1 Acres 100 Lease No. 6091
 Well (Farm) No. 2, 5, 7, 9, 12, 13 Serial No. _____
 Elevation (Spirit Level) No. 2-948' No. 7-892' No. 12-1007' No. 5-991' No. 9-1068' No. 13-993'
 Quadrangle New Martinsville
 County Tyler District Lincoln
 Engineer Don L. Riggle
 Approved by George R. Clarke
 Engineer's Registration No. 102
 File No. 046-SP. 11 Drawing No. 1391
 Date May 20, '48 Scale 1" = 300'

STATE OF WEST VIRGINIA
 DEPARTMENT OF MINES
 OIL AND GAS DIVISION
 CHARLESTON

WELL LOCATION MAP

FILE NO. _____

- + Denotes location of well on United States Topographic Maps, scale 1 to 62,500, latitude and longitude lines being represented by border lines as shown.
- Denotes one inch spaces on border line of original tracing.

J. R. DUNFEE NO. 7 WELL.

628A

Lincoln District, Tyler County, W. Va.
By Maurice Horowitz, 310 N. McKean St., Butler, Pa.
Abandoned under permit Tyl-.....-A?
On.....acres.
Elevation,' L.
Date of completion, etc., not given.
10" casing, 65'; 6½", 1400'; all left in.
Oil well. Record to Dept. of Mines stamped Aug. 2, 1950.
Record to RCT from Mrs. Griffith Sept. 9, 1950. Old File No. 549.

	Top.	Bottom.
Big Injun Sand	1650	1715

"All record shows."



STATE OF WEST VIRGINIA
DEPARTMENT OF MINES
OIL AND GAS DIVISION

319

WELL RECORD

Permit No. TYL-628-A

Oil or Gas Well 011
(KIND)

Company Maurice Horowitz
Address 310 N. McKean St., Butler, Penna.
Farm J. R. Dunfee Acres _____
Location (waters) _____
Well No. 7 Elev. _____
District Lincoln County Tyler
The surface of tract is owned in fee by _____
Address _____
Mineral rights are owned by _____
Address _____
Drilling commenced _____
Drilling completed _____
Date Shot _____ From _____ To _____
With _____
Open Flow _____ /10ths Water in _____ Inch
_____ /10ths Merc. in _____ Inch
Volume _____ Cu. Ft.
Rock Pressure _____ lbs. _____ hrs.
Oil _____ bbls., 1st 24 hrs.
Fresh water _____ feet _____ feet
Salt water _____ feet _____ feet

Casing and Tubing	Used in Drilling	Left in Well	Packers
Size			
16			Kind of Packer
13			
10	65'	65'	Size of
8 1/4			
6 3/4	1400'	1400'	Depth set
5 3/16			
3			Perf. top
2			Perf. bottom
Liners Used			Perf. top
			Perf. bottom

CASING CEMENTED _____ SIZE _____ No. Ft. _____ Dat _____

COAL WAS ENCOUNTERED AT _____ FEET _____ INCHES
_____ FEET _____ INCHES FEET _____ INCHES
_____ FEET _____ INCHES FEET _____ INCHES

Formation	Color	Hard or Soft	Top	Bottom	Oil, Gas or Water	Depth Found	Remarks
Big Injun			1650'	1715'			All record shows

