

Company J.R. Bull

Address Sistersville, W.Va.

Farm J.R. Dunfee

Tract 1 Acres 100 Lease No. 6091

Well (Farm) No. 2, 5, 7, 9, 12+13 Serial No. _____

Elevation (Spirit Level) No. 2-948' No. 7-892' No. 12-1007'
No. 5-991' No. 9-1068' No. 13-993'

Quadrangle New Martinsville

County Tyler District Lincoln

Engineer Don L. Riggle

Approved by George R. Clarke
Engineer's Registration No. 102

File No. 0+G-SP 11 Drawing No. 1391

Date May 20, '48 Scale 1" = 30'

STATE OF WEST VIRGINIA
DEPARTMENT OF MINES
OIL AND GAS DIVISION
CHARLESTON

WELL LOCATION MAP

FILE NO. _____

+ Denotes location of well on United States Topographic Maps, scale 1 to 62,500, latitude and longitude lines being represented by border lines as shown.

- Denotes one inch spaces on border line of original tracing.



STATE OF WEST VIRGINIA
DEPARTMENT OF MINES
OIL AND GAS DIVISION

590

WELL RECORD

Permit No. Reg-631 A


Oil or Gas Well _____ (KIND)

Company Maurice Horowitz
 Address 310 N. Mc Kean St. Butler Penna.
 Farm J. R. Dunfee Acres _____
 Location (waters) _____
 Well No. 13 Elev. _____
 District Lincoln County Tyler
 The surface of tract is owned in fee by _____
 Address _____
 Mineral rights are owned by _____
 Address _____
 Drilling commenced _____
 Drilling completed _____
 Date Shot _____ From _____ To _____
 With _____
 Open Flow _____ /10ths Water in _____ Inch
 _____ /10ths Merc. in _____ Inch
 Volume _____ Cu. Ft.
 Rock Pressure _____ lbs. _____ hrs.
 Oil _____ bbls., 1st 24 hrs.
 Fresh water _____ feet _____ feet
 Salt water _____ feet _____ feet

Casing and Tubing	Used in Drilling	Left in Well	Packers
Size			Kind of Packer
16			
18			
10			Size of
8 1/4	<u>40</u> <u>465</u>	<u>40</u> <u>None</u>	Depth set
6 5/8	<u>1372</u>	<u>1372</u>	
5 3/16			
3			Perf. top
2			Perf. bottom
Liners Used			Perf. top
			Perf. bottom

CASING CEMENTED _____ SIZE _____ No. Ft. _____ Date _____
 COAL WAS ENCOUNTERED AT _____ FEET _____ INCHES
 _____ FEET _____ INCHES FEET _____ INCHES
 _____ FEET _____ INCHES FEET _____ INCHES

Formation	Color	Hard or Soft	Top	Bottom	Oil, Gas or Water	Depth Found	Remarks
<u>Big Injun</u>			<u>1760</u>	<u>1858</u>			<u>All Record Shows</u>

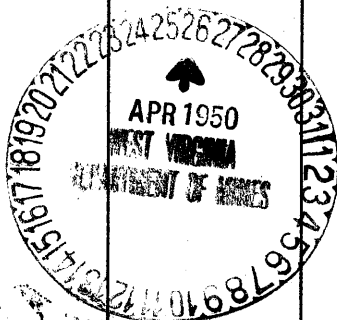

NOV 18 1950