
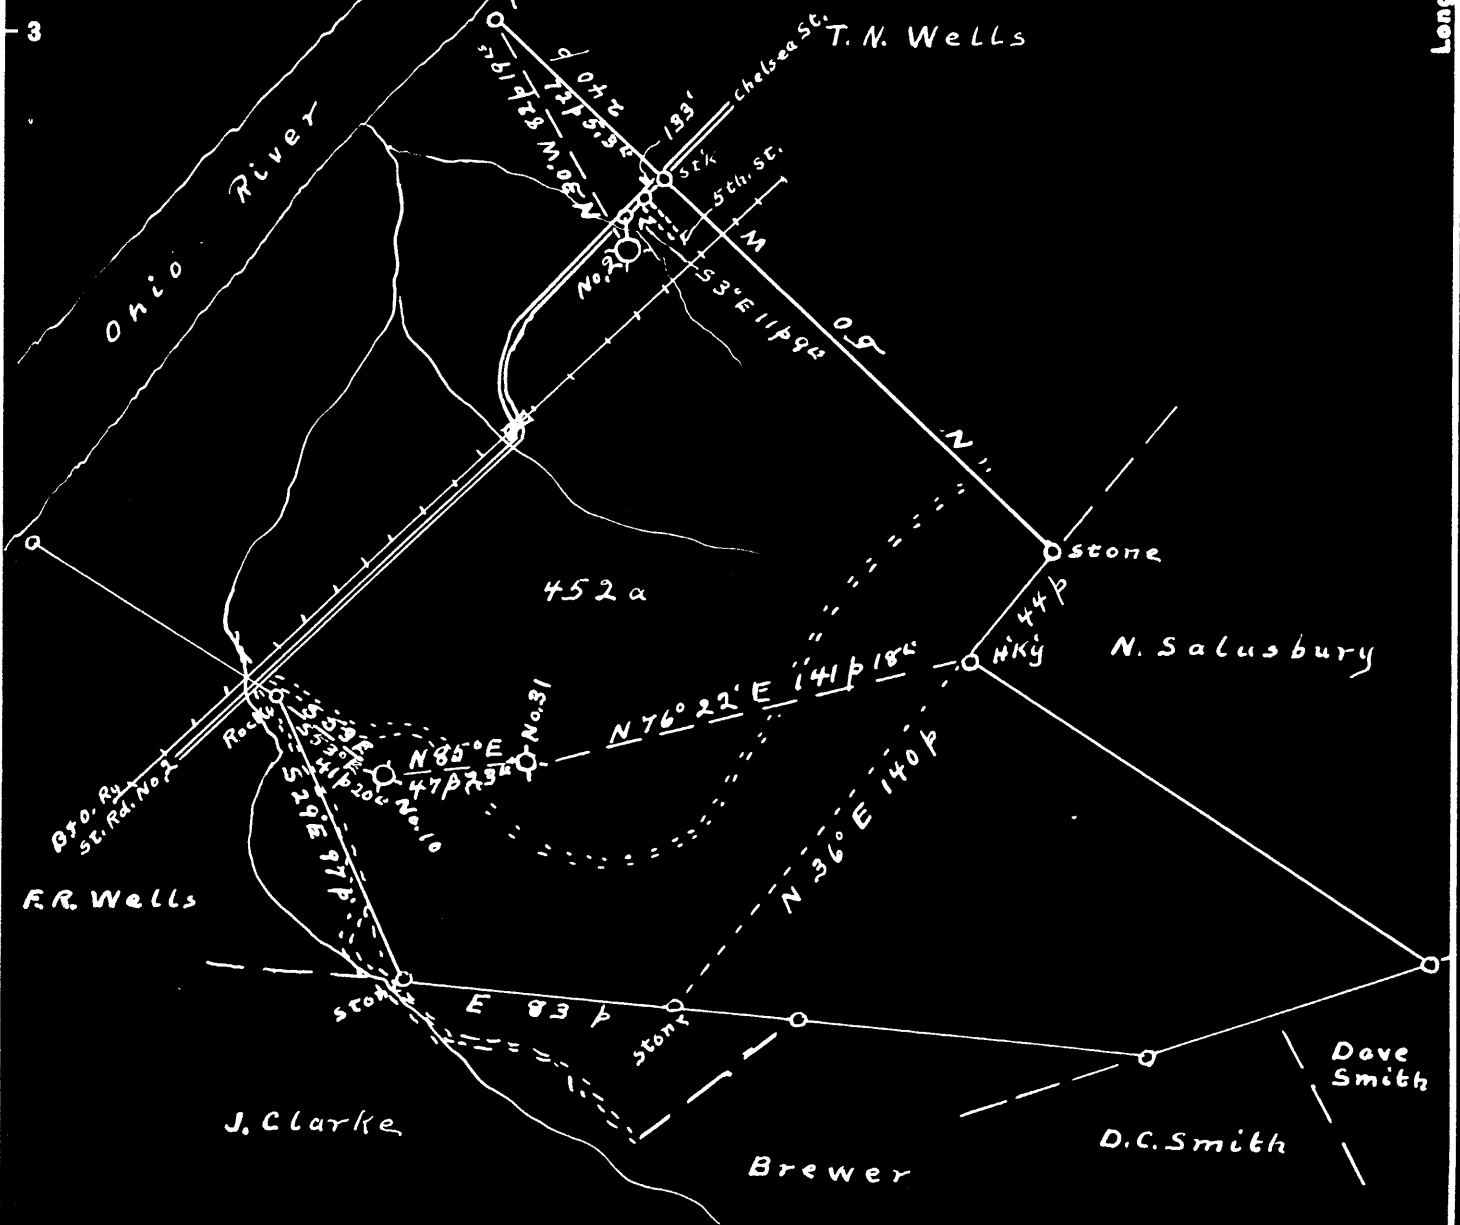


Latitude 39° 35'

Longitude 81° 00'

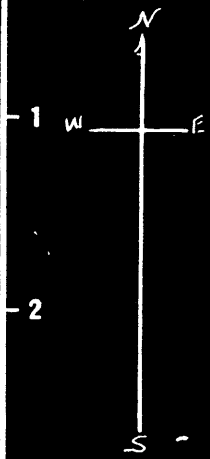

- New Location...
- Drill Deeper.....
- Abandonment.....

Company J.R. Bull
 Address Sistersville, W. Va.
 Farm Eph Wells
 Tract 1 Acres 452 Lease No. 6078
 Well (Farm) No. 2-10+31 Serial No. No. 2 - 635' No. 31 - 776
 Elevation (Spirit Level) No. 10 - 760
 Quadrangle New Matamoras
 County Tyler District Lincoln
 Engineer Don L. Riggle
 Approved by George R. Clarke
 Engineer's Registration No. 102
 File No. 046-S.P. 11 Drawing No. 1386
 Date May 5, '48 Scale 1" = 60 p

STATE OF WEST VIRGINIA
 DEPARTMENT OF MINES
 OIL AND GAS DIVISION
 CHARLESTON

WELL LOCATION MAP
 TYL - 610 - A - 2
 FILE NO. TYL - 632 - A - 10
 TYL - 633 - A - 31

+ Denotes location of well on United States Topographic Maps, scale 1 to 62,500, latitude and longitude lines being represented by border lines as shown.

- Denotes one inch spaces on border line of original tracing.

EPH WELLS NO. 31 WELL.

1633R

Lincoln District, Tyler County, W. Va.
By Maurice Herowitz, 310 N. McKean St., Butler, Pa.
Abandoned under permit Tyl-.....-A?
On.....acres.
Elevation,! L.
Date of completion, etc., not given.
6 1/4" casing, 1200'.
Oil well. Record to Dept. of Mines stamped April 26, 1950.
Record to RCT from Mrs. Griffith June 24, 1951. Old File No. 600.

	Top.	Bottom.
Big Injun Sand	1558	- 1593

"All record shows".



STATE OF WEST VIRGINIA
DEPARTMENT OF MINES
OIL AND GAS DIVISION

WELL RECORD

600

Permit No. Ab 633-A

Oil or Gas Well Oil
(KIND)

Company Maurice Morowitz
 Address 310 N. Mc Kean St. Butler Pa.
 Farm EPH Wells Acres _____
 Location (waters) _____
 Well No. 31 Elev. _____
 District Lincoln County Tyler
 The surface of tract is owned in fee by _____
 Address _____
 Mineral rights are owned by _____
 Address _____
 Drilling commenced _____
 Drilling completed _____
 Date Shot _____ From _____ To _____
 With _____
 Open Flow _____ /10ths Water in _____ Inch
 _____ /10ths Merc. in _____ Inch
 Volume _____ Cu. Ft.
 Rock Pressure _____ lbs. _____ hrs.
 Oil _____ bbls., 1st 24 hrs.
 Fresh water _____ feet _____ feet
 Salt water _____ feet _____ feet

Casing and Tubing	Used in Drilling	Left in Well	Packers
Size			
16			Kind of Packer
13			
10			Size of
8 1/4			
6 3/4	1200	1200	Depth set
5 3/16			
3			Perf. top
2			Perf. bottom
Liners Used			Perf. top
			Perf. bottom

CASING CEMENTED _____ SIZE _____ No. Ft. _____ Date _____
 COAL WAS ENCOUNTERED AT _____ FEET _____ INCHES
 _____ FEET _____ INCHES FEET _____ INCHES
 _____ FEET _____ INCHES FEET _____ INCHES

Formation	Color	Hard or Soft	Top	Bottom	Oil, Gas or Water	Depth Found	Remarks
Big Injun			1558	1593			All Record Shows

