

	Latitude	39° 35'
	Longitude	80° 53'
#2	W 370	
635-A	S 1.56	
#3	W 3.64	
636-A	S 1.37	
#4	W 3.33	
637-A	S 1.01	
#5	W 3.42	

510-A	S 1.56
#1	W 3.52
511-A	S 1.22
#7	W 3.51

Company J.R. Bull
 Address Sistersville, W.Va.
 Farm Thistle-McFadden
 Tract 1 Acres 99 3/4 Lease No. 6080
 Well (Farm) No. 1, 4, 7, 8, 9, 13 Serial No. 15
 Elevation (Spirit Level) 1-861' 8-992' 13-1054'
 Quadrangle New Martinsville
 County Tyler District Lincoln
 Engineer Don L. Riggle
 Engineer's Registration No. SW
 File No. 046-S.P. 11 Drawing No. 1390
 Date Nov 18, '48 Scale 1" = 300'

STATE OF WEST VIRGINIA
 DEPARTMENT OF MINES
 OIL AND GAS DIVISION
 CHARLESTON
 Tyl-639-A #7
 Tyl-635-A #8
 Tyl-636-A #9
 Tyl-637-A #13
WELL LOCATION MAP
 FILE NO. JYL-510-#1
JYL-512-A-#15 JYL-511-A-#7
 + Denotes location of well on United States Topographic Maps, scale 1 to 62,500, latitude and longitude lines being represented by border lines as shown.
 - Denotes one inch spaces on border line of original tracing.



STATE OF WEST VIRGINIA
DEPARTMENT OF MINES
OIL AND GAS DIVISION

611

WELL RECORD

Permit No. TYL-636-A

Oil or Gas Well Oil
(KIND)


Company Maurice Horowitz
 Address 310 N. McKean St., Butler, Penna.
 Farm Thistle McFadden Acres _____
 Location (waters) _____
 Well No. 9 Elev. _____
 District Lincoln County Tyler
 The surface of tract is owned in fee by _____
 Address _____
 Mineral rights are owned by _____
 Address _____
 Drilling commenced _____
 Drilling completed _____
 Date Shot _____ From _____ To _____
 With _____
 Open Flow _____ /10ths Water in _____ Inch
 _____ /10ths Merc. in _____ Inch
 Volume _____ Cu. Ft.
 Rock Pressure _____ lbs. _____ hrs.
 Oil _____ bbls., 1st 24 hrs.
 Fresh water _____ feet _____ feet
 Salt water _____ feet _____ feet

Casing and Tubing	Used in Drilling	Left in Well	Packers
Size			
16			Kind of Packer
13			
10			Size of
8 1/4	780'	780'	
6 3/4	1487'	1487'	Depth set
5 3/16			
3			Perf. top
2			Perf. bottom
Liners Used			Perf. top
			Perf. bottom

CASING CEMENTED _____ SIZE _____ No. Ft. _____ Dat _____

COAL WAS ENCOUNTERED AT _____ FEET _____ INCHES
 _____ FEET _____ INCHES _____ FEET _____ INCHES
 _____ FEET _____ INCHES _____ FEET _____ INCHES

Formation	Color	Hard or Soft	Top	Bottom	Oil, Gas or Water	Depth Found	Remarks
Big Injun			1863'	1900'			All records shows

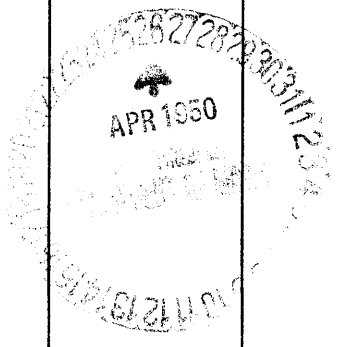

(Over) AUG 17 1951

Lincoln District, Tyler County, W. Va.

By Maurice Forewitz, 310 N. McBurn St., Butler, Pa.

Abandoned under permit Tyl-.....-11

.....-2708.

Elevation,' l.

Date of completion, etc., not given.

8" casing, 200'; 6" casing, 1400'; all left in.

Oil well. Record to Dept. of Mines stopped April 26, 1950.

Record to DEP from Mrs. Griffith Aug. 17, 1951. Old File No. 619.

Big Injun Sand

Top. Bottom.

1863 - 1900

"All record shows."