

New Location...
 Drill Deeper.....
 Abandonment.....

S 298
 W 018

Map Sh 60 S 5 W 12 F.B. 953 P-8-9-10

Company Hope Natural Gas Co.
 Address Clarksburg, W. Va.
 Farm P.P. Doak
 Tract _____ Acres 29 Lease No. 4789
 Well (Farm) No. _____ Serial No. 1546
 Elevation (Spirit Level) 972'
 Quadrangle West Union
 County Tyler District Centerville
 Engineer W.M. Bowers
 Engineer's Registration No. 900
 File No. _____ Drawing No. _____
 Date 8-1-50 Scale 1" = 20 P

STATE OF WEST VIRGINIA
 DEPARTMENT OF MINES
 OIL AND GAS DIVISION
 CHARLESTON

WELL LOCATION MAP
 FILE NO. JYL-650-A

+ Denotes location of well on United States Topographic Maps, scale 1 to 62,500, latitude and longitude lines being represented by border lines as shown.

- Denotes one inch spaces on border line of original tracing.



STATE OF WEST VIRGINIA
DEPARTMENT OF MINES
OIL AND GAS DIVISION

584

WELL RECORD

Permit No. 650-A


~~Oil~~ Well Gas
(KIND)

Company Hope Naural Gas Company.
Address 445 West Main St. Clarksburg, W. Va.
Farm P. P. Doak Acres 29
Location (waters) _____
Well No. 1546 Elev. 972
District Centerville County Tyler
The surface of tract is owned in fee by _____
Address _____
Mineral rights are owned by _____
Address _____
Drilling commenced Jan. 20, 1910
Drilling completed Mar. 1, 1910
Date Shot _____ From _____ To _____
With _____
Open Flow _____ /10ths Water in _____ Inch
_____ /10ths Merc. in _____ Inch
Volume _____ Cu. Ft.
Rock Pressure _____ lbs. _____ hrs.
Oil _____ bbls., 1st 24 hrs.
Fresh water 465 feet _____ feet
Salt water 1745 feet _____ feet

Casing and Tubing	Used in Drilling	Left in Well	Packers
Size			Kind of Packer
16			
13			
10	280	280	Size of
8 1/4	1243	1243	
6 1/2	1762	1762	Depth set
5 3/16			
3	1992	1992	Perf. top
2			Perf. bottom
Liners Used			Perf. top
			Perf. bottom

NOT
CASING CEMENTED _____ SIZE _____ No. Ft. _____ Date _____
COAL WAS ENCOUNTERED AT 322 FEET 36 INCHES
_____ FEET _____ INCHES _____ FEET _____ INCHES
_____ FEET _____ INCHES _____ FEET _____ INCHES

Formation	Color	Hard or Soft	Top	Bottom	Oil, Gas or Water	Depth Found	Remarks
Pittsburgh Coal			322	325	water	465	
Gas sand			1115	1150			
First Salt			1250	1300			
Second Salt			1348	1475			
Maxon			1740	1772			
Little Lime			1780	1795			
Pencil cave			1795	1810			
Big Lime			1810	1888			
Big Injun			1888	1989	gas	1894-1935-67	
Total depth				1992			

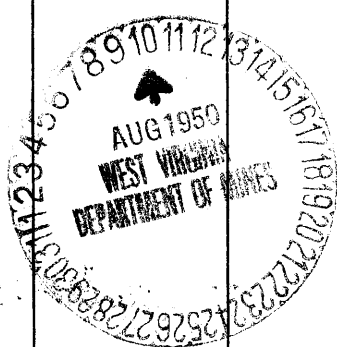

(Over) FEB 23 1951

Formation	Color	Hard or Soft	Top	Bottom	Oil, Gas or Water	Depth Found	Remarks

Date August 8, 1950., 19__

APPROVED Hope Natural Gas Company., Owner

By _____

(T) 