

S 3.18
W 0.41

New Location
 Drill Deeper
 Abandonment

NOTE: Surface of that part of F.R. Ball tract on which Well No. 11 is situate is owned by Carl and Glenna R. McMasters, whose post office address is Dale, West Va. No coal

Company BROADWATER, WELCH & TRAVIS
 Address West Union, W. Va.
 Farm F.R. Ball
 Tract _____ Acres 228 Lease No. _____
 Well (Farm) No. Eleven Serial No. _____
 Elevation (Spirit Level) 955
 Quadrangle Centerpoint
 County Tyler District McElroy
 Engineer W. S. Hart
 Engineer's Registration No. 1227
 File No. _____ Drawing No. _____
 Date August, 1950 Scale 1" = 1000'

STATE OF WEST VIRGINIA
 DEPARTMENT OF MINES
 OIL AND GAS DIVISION
 CHARLESTON

WELL LOCATION MAP
 FILE NO. JYL-656-A

+ Denotes location of well on United States Topographic Maps, scale 1 to 62,500, latitude and longitude lines being represented by border lines as shown.

- Denotes one inch spaces on border line of original tracing.



STATE OF WEST VIRGINIA
DEPARTMENT OF MINES
OIL AND GAS DIVISION

581

Ab 656-A
Permit No.

WELL RECORD


Oil or Gas Well 011
(KIND)

Company ~~Breadwater, Welch and Travis~~
Address ~~West Union, W. Va.~~
Farm F. R. Ball Acres 228
Location (waters) Indian creek
Well No. 11 Elev. 955
District McIntire County Taylor
The surface of tract is owned in fee by Carl and Glenna
McMasters Address Dale, W. Va.
Mineral rights are owned by F. R. Ball hrs.
Address Dale, W. Va.
Drilling commenced _____
Drilling completed _____
Date Shot _____ From _____ To _____
With _____
Open Flow _____ /10ths Water in _____ Inch
_____ /10ths Merc. in _____ Inch
Volume _____ Cu. Ft.
Rock Pressure _____ lbs. _____ hrs.
Oil _____ bbls., 1st 24 hrs.
Fresh water _____ feet _____ feet
Salt water _____ feet _____ feet

Casing and Tubing	Used in Drilling	Left in Well	Packers
Size			Kind of Packer
16			
13			
10	<u>320</u>	<u>pulled</u>	Size of
8 1/4	<u>1333</u>	<u>959</u>	
6 5/8	<u>1700</u>	<u>pulled</u>	Depth set
5 3/16	<u>2173</u>	<u>2173</u>	
3			Perf. top
2			Perf. bottom
Liners Used			Perf. top
			Perf. bottom

CASING CEMENTED _____ SIZE _____ No. Ft. _____ Date _____
COAL WAS ENCOUNTERED AT No record INCHES
FEEET INCHES FEEET INCHES
FEEET INCHES FEEET INCHES

Formation	Color	Hard or Soft	Top	Bottom	Oil, Gas or Water	Depth Found	Remarks
Big Ingon			2040				
Gordon			2778				
Total Depth				2812	011	2790	

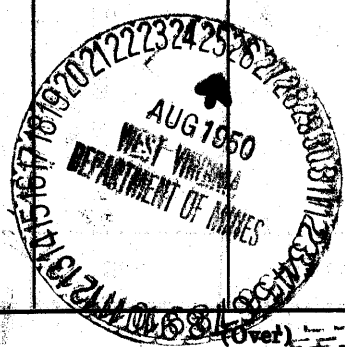

FEB 23 1951

Formation	Color	Hard or Soft	Top	Bottom	Oil, Gas or Water	Depth Found	Remarks

Date August, 24, 1950., 19

APPROVED Broadwater, Welch and Travis, Owner

By C. B. Travis partner
(Title)