

New Location...
 Drill Deeper.....
 Abandonment.....

Map Sh 60 56 W 12 FB. 971-P-12-13

Company Hope Natural Gas Co.
 Address Clarksburg, W.Va.
 Farm A.U. Davis
 Tract _____ Acres 53 Lease No. 4521
 Well (Farm) No. _____ Serial No. 3555
 Elevation (Spirit Level) 885'
 Quadrangle West Union
 County Tyler District Centerville
 Engineer W.M. Bowers
 Engineer's Registration No. 900
 File No. _____ Drawing No. _____
 Date 8-25-50 Scale 1" = 20P

STATE OF WEST VIRGINIA
 DEPARTMENT OF MINES
 OIL AND GAS DIVISION
 CHARLESTON

WELL LOCATION MAP
 FILE NO. JYL-657-A

+ Denotes location of well on United States Topographic Maps, scale 1 to 62,500, latitude and longitude lines being represented by border lines as shown.
 - Denotes one inch spaces on border line of original tracing.



STATE OF WEST VIRGINIA
DEPARTMENT OF MINES
OIL AND GAS DIVISION

582

Permit No. 657A

WELL RECORD

Oil Gas Well (KIND)


Company Hope Natural Gas Company.
Address 445 West Main St. Clarksburg, W. Va.
Farm A. U. Davis. Acres 3
Location (waters) _____
Well No. 3555 Elev. 685
District Centerville County Tyler
The surface of tract is owned in fee by _____
Address _____
Mineral rights are owned by _____
Address _____
Drilling commenced July 8, 1914
Drilling completed August 20, 1914
Date Shot _____ From _____ To _____
With _____
Open Flow _____ /10ths Water in _____ Inch
_____ /10ths Merc. in _____ Inch
Volume _____ Cu. Ft.
Rock Pressure _____ lbs. _____ hrs.
Oil _____ bbls., 1st 24 hrs.
Fresh water none recorded feet _____ feet
Salt water none recorded feet _____ feet

Casing and Tubing	Used in Drilling	Left in Well	Packers
Size			Kind of Packer
16			
13			
10	260	Pulled	Size of
8 1/4	987	987	
6 1/2	1765	1765	Depth set
5 3/16	1784	1784	
3			Perf. top
2			Perf. bottom
Liners Used			Perf. top
			Perf. bottom

CASING CEMENTED Not SIZE _____ No. Ft. _____ Date _____

COAL WAS ENCOUNTERED AT 220 FEET 60 Est INCHES
505 FEET 72 Est INCHES FEET INCHES
FEET INCHES FEET INCHES

Formation	Color	Hard or Soft	Top	Bottom	Oil, Gas or Water	Depth Found	Remarks
Coal			220	225 Est			
Pitts. Coal			505	511 Est			
Little Dunkard			945	960			
Big Dunkard			1010	1050			
Gas sand			1165	1185			
First Salt			1220	1275			
Second Salt			1308	1410			
Maxon			1636	1670			
Little Lime			1690	1719			
Pencil Cave			1719	1726			
Big Lime			1726	1790			
Big Injun			1790	1899	gas 1800	27 82	
Total depth				1972			

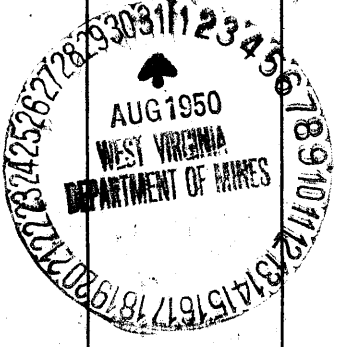

Formation	Color	Hard or Soft	Top	Bottom	Oil, Gas or Water	Depth Found	Remarks

Date August 24, 1950., 19

APPROVED Hope Natural Gas Company., Owner

By _____

(Title) *[Signature]*