


Latitude 39° 35'

Longitude 81° 00'

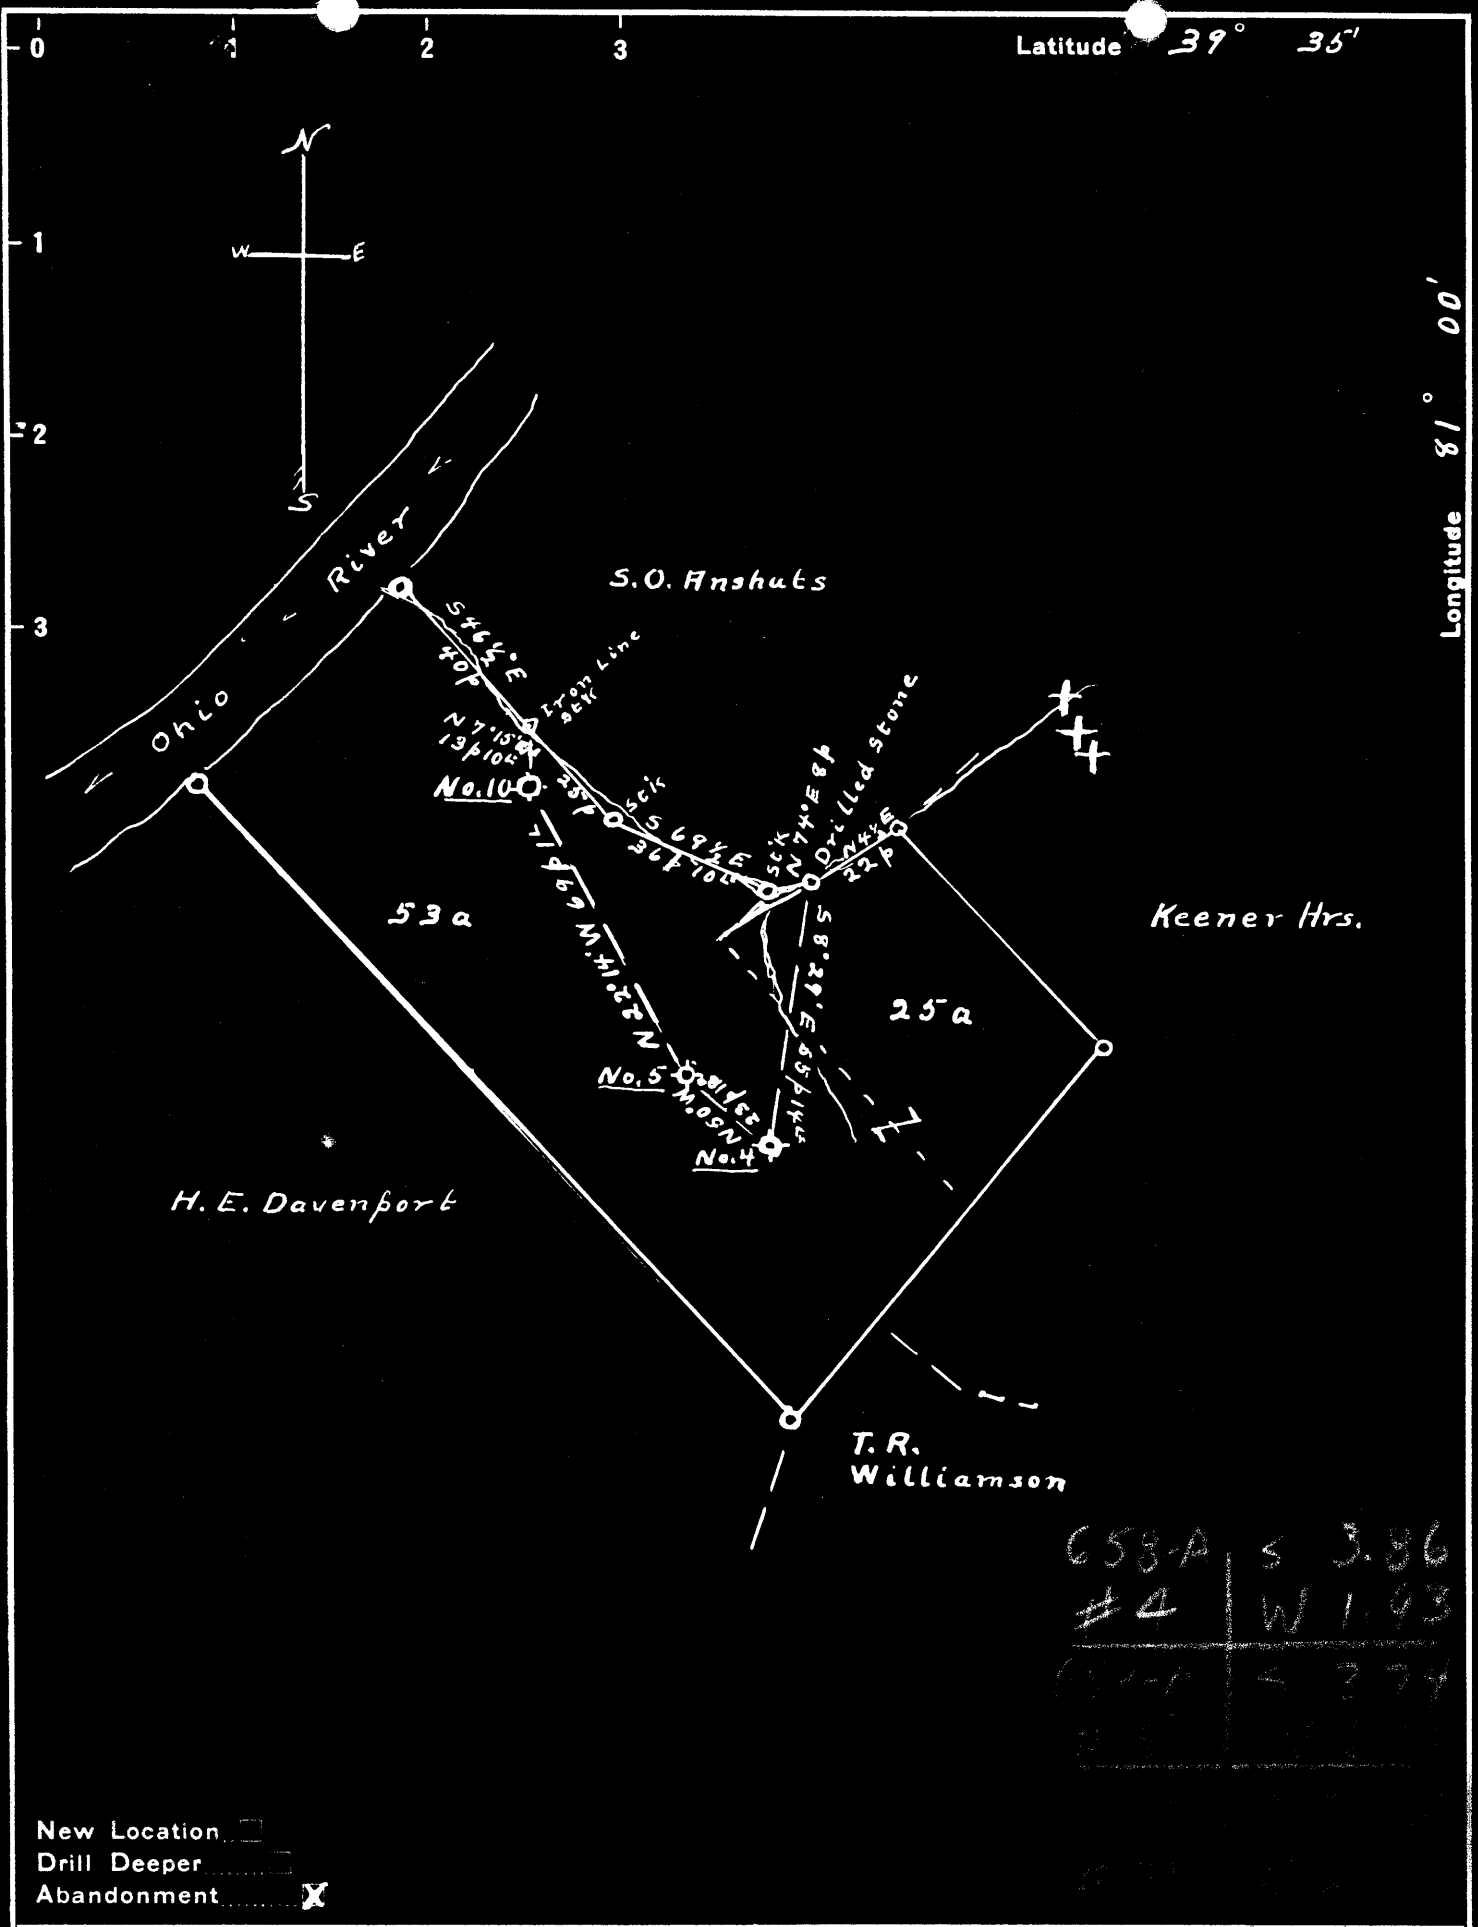

New Location
 Drill Deeper
 Abandonment

Company J.R. Bull
 Address Sistersville, W.Va.
 Farm J.H. Davenport
 Tract 1 Acres 53a Lease No. 6140
 Well (Farm) No.'s 4-5-10 Serial No. No. 4-793, No. 10-628
 Elevation (Spirit Level) No. 5-857'
 Quadrangle New Matamoras
 County Tyler District Union
 Engineer Don L. Riggle
 Approved by George R. Clarke
 Engineer's Registration No. 102
 File No. 046-SP11 Drawing No. 1383
 Date Apr. 26, '48 Scale 1" = 40p

STATE OF WEST VIRGINIA
 DEPARTMENT OF MINES
 OIL AND GAS DIVISION
 CHARLESTON

WELL LOCATION MAP

JYL-658-A-#4
 FILE NO. JYL-659-A-#5
JYL-660-A-#10

+ Denotes location of well on United States Topographic Maps, scale 1 to 62,500, latitude and longitude lines being represented by border lines as shown.

- Denotes one inch spaces on border line of original tracing.

39A

.....District, Tyler County, W. Va.
Fisher Oil Co.
Sistersville field.
8½" casing, 748'; 6½", 1247'.

	Top.	Bottom.
1st pay	1582	
Total depth		1639



STATE OF WEST VIRGINIA
DEPARTMENT OF MINES
OIL AND GAS DIVISION

565

Permit No. Lyl-659-Pl

WELL RECORD


Oil or Gas Well _____
(KIND)

Company Mourice Horowitz
 Address 310 N. McKean St. Butler Penna.
 Farm F. & R. Davenport Acres _____
 Location (waters) _____
 Well No. 5 Elev. _____
 District Roanoke County Jeffers
 The surface of tract is owned in fee by _____
 Address _____
 Mineral rights are owned by _____
 Address _____
 Drilling commenced _____
 Drilling completed _____
 Date Shot _____ From _____ To _____
 With _____
 Open Flow _____ /10ths Water in _____ Inch
 _____ /10ths Merc. in _____ Inch
 Volume _____ Cu. Ft.
 Rock Pressure _____ lbs. _____ hrs.
 Oil _____ bbls., 1st 24 hrs.
 Fresh water _____ feet _____ feet
 Salt water _____ feet _____ feet

Casing and Tubing	Used in Drilling	Left in Well	Packers
Size			
16			Kind of Packer
13			
10			Size of
8 1/4	<u>748</u>	<u>748</u>	
6 5/8	<u>1247</u>	<u>1247</u>	Depth set
5 3/16			
3			Perf. top
2			Perf. bottom
Liners Used			Perf. top
			Perf. bottom

CASING CEMENTED _____ SIZE _____ No. Ft. _____ Date _____
 COAL WAS ENCOUNTERED AT _____ FEET _____ INCHES
 _____ FEET _____ INCHES FEET _____ INCHES
 _____ FEET _____ INCHES FEET _____ INCHES

Formation	Color	Hard or Soft	Top	Bottom	Oil, Gas or Water	Depth Found	Remarks
<u>Injun</u>				<u>1639</u>	<u>oil</u>		<u>All given on record.</u>

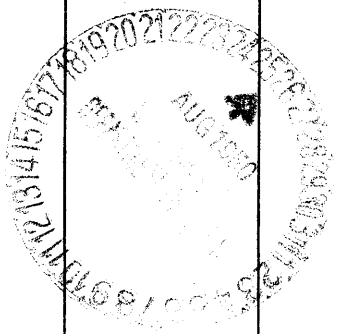

0