

S 3.88
W 1.14

NOTE: Surface now owned by W. A. Wharton, whose postoffice address is Alvy, W. Va. No coal.

New Location
 Drill Deeper
 Abandonment

Company **BROADWATER, WELCH & TRAVIS**
 Address **West Union, West Va.**
 Farm **Hannah J. Ingram**
 Tract _____ Acres **33.75** Lease No. _____
 Well (Farm) No. **One** Serial No. _____
 Elevation (Spirit Level) **975**
 Quadrangle **Centerpoint**
 County **Tyler** District **McElroy** NW
 Engineer **W. A. Wharton**
 Engineer's Registration No. **1227**
 File No. _____ Drawing No. _____
 Date **August, 1950** Scale **1" = 500'**

STATE OF WEST VIRGINIA
 DEPARTMENT OF MINES
 OIL AND GAS DIVISION
 CHARLESTON

WELL LOCATION MAP
 FILE NO. **JYL-673-A**

+ Denotes location of well on United States Topographic Maps, scale 1 to 62,500, latitude and longitude lines being represented by border lines as shown.
 - Denotes one inch spaces on border line of original tracing.



STATE OF WEST VIRGINIA
DEPARTMENT OF MINES
OIL AND GAS DIVISION

586

Ab 673-A

WELL RECORD

Permit No.

Oil or Gas Well Oil
(KIND)

Company Broadwater, Welch and Travis
Address West Union or Pennsboro, W. Va.
Farm H. J. Ingram Acres 33.75
Location (waters) Indian creek
Well No. 1 Elev. 975
District McElroy County Tyler
The surface of tract is owned in fee by W. A. Warton
Address Alvy, W. Va.
Mineral rights are owned by H. J. Ingram Hrs.
Address Alvy, W. Va.
Drilling commenced no record
Drilling completed " "
Date Shot 1-7-03 From at 2877 To
With 150 qts.
Open Flow /10ths Water in _____ Inch
/10ths Merc. in _____ Inch
Volume _____ Cu. Ft.
Rock Pressure _____ lbs. _____ hrs.
Oil _____ bbls., 1st 24 hrs.
Fresh water _____ feet _____ feet
Salt water _____ feet _____ feet

Casing and Tubing	Used in Drilling	Left in Well	Packers
Size			Kind of Packer
16			
13			
10	300	pulled	Size of
8 1/4	1367	"	
6 1/2	2151	2151	Depth set
5 3/16	2286	2286	
3			Perf. top
2			Perf. bottom
Liners Used			Perf. top
			Perf. bottom

CASING CEMENTED _____ SIZE _____ No. Ft. _____ Dat


COAL WAS ENCOUNTERED AT no record INCHES

FEEET INCHES FEET INCHES

FEEET INCHES FEET INCHES

Formation	Color	Hard or Soft	Top	Bottom	Oil, Gas or Water	Depth Found	Remarks
Big Ingun Gordon Total Depth			2145 2875	2894	oil	2880	

C

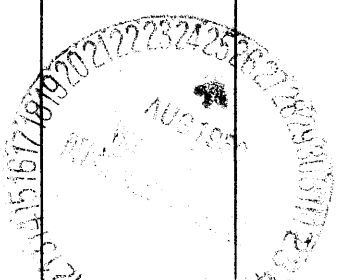

Formation	Color	Hard or Soft	Top	Bottom	Oil, Gas or Water	Depth Found	Remarks

Date June, 4 - 1949, 19

APPROVED Broadwater, Welch & Travis, Owner

By C. O. Travis partner
(Title)