

Company BROADWATER, WELCH & TRAVIS

Address West Union, W. Va.

Farm Thompson Heirs

Tract \_\_\_\_\_ Acres 90.5 Lease No. \_\_\_\_\_

Well (Farm) No. Seven Serial No. \_\_\_\_\_

Elevation (Spirit Level) 1140

Quadrangle Centerpoint

County Tyler District McElroy

Engineer [Signature]

Engineer's Registration No. 1227

File No. \_\_\_\_\_ Drawing No. \_\_\_\_\_

Date August Scale 1" = 500'

STATE OF WEST VIRGINIA  
DEPARTMENT OF MINES  
OIL AND GAS DIVISION  
CHARLESTON

WELL LOCATION MAP  
FILE NO. JYL-674-A

+ Denotes location of well on United States Topographic Maps, scale 1 to 62,500, latitude and longitude lines being represented by border lines as shown.

- Denotes one inch spaces on border line of original tracing.



STATE OF WEST VIRGINIA  
DEPARTMENT OF MINES  
OIL AND GAS DIVISION

579

AD 674-A

WELL RECORD

Oil or Gas Well Oil  
(KIND)

Permit No. 674-A

Company Broadwater, Welch and Travis  
Address West Union, W. Va.  
Farm Thompson Heirs Acres 90.5  
Location (waters) Stackpole run  
Well No. 7 Elev. 1140  
District McElroy County Tyler  
The surface of tract is owned in fee by Bea Stackpole  
Address Alvy, W. Va.  
Mineral rights are owned by Thompson Heirs.  
Address Alvy, W. Va.


Casing and Tubing	Used in Drilling	Left in Well	Packers
Size			Kind of Packer
16			
13			
10	310	310	Size of
8 1/4	1350	1350	
6 5/8	1640	1640	Depth set
5 3/16	2250	2250	
3			Perf. top
2			Perf. bottom
Liners Used			Perf. top
			Perf. bottom

Drilling commenced \_\_\_\_\_  
Drilling completed \_\_\_\_\_  
Date Shot \_\_\_\_\_ From \_\_\_\_\_ To \_\_\_\_\_  
With \_\_\_\_\_  
Open Flow \_\_\_\_\_ /10ths Water in \_\_\_\_\_ Inch  
\_\_\_\_\_ /10ths Merc. in \_\_\_\_\_ Inch  
Volume \_\_\_\_\_ Cu. Ft.  
Rock Pressure \_\_\_\_\_ lbs. \_\_\_\_\_ hrs.  
Oil \_\_\_\_\_ bbls., 1st 24 hrs.  
Fresh water \_\_\_\_\_ feet \_\_\_\_\_ feet  
Salt water \_\_\_\_\_ feet \_\_\_\_\_ feet

CASING CEMENTED \_\_\_\_\_ SIZE \_\_\_\_\_ No. Ft. \_\_\_\_\_ Date \_\_\_\_\_  
COAL WAS ENCOUNTERED AT No return INCHES  
\_\_\_\_\_ FEET \_\_\_\_\_ INCHES \_\_\_\_\_ FEET \_\_\_\_\_ INCHES  
\_\_\_\_\_ FEET \_\_\_\_\_ INCHES \_\_\_\_\_ FEET \_\_\_\_\_ INCHES

Formation	Color	Hard or Soft	Top	Bottom	Oil, Gas or Water	Depth Found	Remarks
Big Ingun			2125				
Gordon			2360				
Total Depth				2382	Oil	2364	

Handwritten mark resembling a stylized 'C' or 'G' with an arrow pointing to the right.

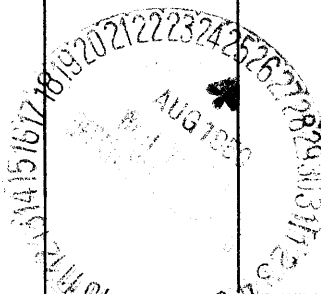

Formation	Color	Hard or Soft	Top	Bottom	Oil, Gas or Water	Depth Found	Remarks

Date August, 24, 1950., 19

APPROVED Broadwater, Welch and Travis, Owner

By C. O. Travis partner.  
(Title)