

Company Melrose Oil & Gas Co.
 Address Sistersville, W. Va.
 Farm Geo. O. Doak
 Tract 1 Acres 75 Lease No. _____
 Well (Farm) No. 1 Serial No. _____
 Elevation (Spirit Level) 1114.9'
 Quadrangle West Union
 County Tyler District Meade
 Engineer J. M. Cochran
 Engineer's Registration No. Co. Surveyor
 File No. _____ Drawing No. _____
 Date 10-30-50 Scale 1" = 800'

STATE OF WEST VIRGINIA
 DEPARTMENT OF MINES
 OIL AND GAS DIVISION
 CHARLESTON

WELL LOCATION MAP
 FILE NO. JYL-676-A

+ Denotes location of well on United States Topographic Maps, scale 1 to 62,500, latitude and longitude lines being represented by border lines as shown.

- Denotes one inch spaces on border line of original tracing.



STATE OF WEST VIRGINIA
DEPARTMENT OF MINES
OIL AND GAS DIVISION

583

WELL RECORD

Permit No. 676-A Oil or Gas Well Oil (KIND)

Company Melrose Oil & Gas Co.
 Address Box 192, Sistersville, W. Va.
 Farm G O Doak Acres 75
 Location (waters) _____
 Well No. 1 Elev. 1114.9'
 District Meade County Tyler
 The surface of tract is owned in fee by G O Doak
 Address Wick, W. Va.
 Mineral rights are owned by Melrose Oil & Gas Co.
 Address Sistersville, W. Va.
 Drilling commenced June 18 1907
 Drilling completed Aug. 26 1907
 Date Shot _____ From _____ To _____
 With _____
 Open Flow _____ /10ths Water in _____ Inch
 _____ /10ths Merc. in _____ Inch
 Volume _____ Cu. Ft.
 Rock Pressure _____ lbs. _____ hrs.
 Oil _____ bbls., 1st 24 hrs.
 Fresh water _____ feet _____ feet
 Salt water _____ feet _____ feet


Casing and Tubing	Used in Drilling	Left in Well	Packers
Size			Kind of Packer
16			
13			
10	185	None	Size of
8 1/4	1190	"	
6 5/8	1726	1726	Depth set
5 3/16			
3			Perf. top
2			Perf. bottom
Liners Used			Perf. top
			Perf. bottom

CASING CEMENTED _____ SIZE _____ No. Ft. _____ Date _____

COAL WAS ENCOUNTERED AT _____ FEET _____ INCHES
 _____ FEET _____ INCHES _____ FEET _____ INCHES
 _____ FEET _____ INCHES _____ FEET _____ INCHES

Formation	Color	Hard or Soft	Top	Bottom	Oil, Gas or Water	Depth Found	Remarks
Maxon			1870				
Pay			1953	1973			
Keener			1979	1996			

U

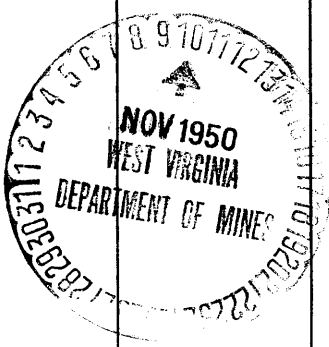

(Over)

FILED 1951
 FEB 20 1951