

NOTE:- Surface owned by B.F. & Mary E. Chapman, whose post office address is Pursley, Tyler County, West Va. No coal in this vicinity

JYL-688-A TO BE PLUGGED BY DAN HENTHORN SISTERSVILLE, W. VA. Oct. 15, 1958

New Location..   
 Drill Deeper.....   
 Abandonment.....

OCT 27 1958

Sheet No. 2 of 3 sheets

Company **VALLEY STEEL PRODUCTS CO.**  
 Address **St. Louis, Mo.**  
 Farm **R. F. Rice**  
 Tract \_\_\_\_\_ Acres **(156)** Lease No. \_\_\_\_\_  
 Well (Farm) No. **1, 2 and 5** Serial No. \_\_\_\_\_  
 Elevation (Spirit Level) **No. 1 - 1075, No. 2 - 1110, No. 5 - 1005'**  
 Quadrangle **New Martinaville**  
 County **Tyler** District **Ellsworth**  
 Engineer **W. H. H. H. H.**  
 Engineer's Registration No. **1227**  
 File No. \_\_\_\_\_ Drawing No. \_\_\_\_\_  
 Date **March, 1951** Scale **1" = 500'**

STATE OF WEST VIRGINIA  
 DEPARTMENT OF MINES  
 OIL AND GAS DIVISION  
 CHARLESTON

**WELL LOCATION MAP**  
 JYL-688-A-#1  
 FILE NO. **JYL-689-A-#2**  
**JYL-691-A-#5**

+ Denotes location of well on United States Topographic Maps, scale 1 to 62,500, latitude and longitude lines being represented by border lines as shown.

- Denotes one inch spaces on border line of original tracing.

R. F. RICE NO. 1 - (Nos. 2 & No. 5) (DAN HENTHORN) (TYL-689A & 691-A) VALLEY STEEL PRODUCTS CO. - TYL-688A

R. F. RICE NO. 4 WELL.

Ellsworth District, Tyler County, W. Va.

By Valley Steel Products Co., St. Louis, Mo.

Abandoned under permit Tyl-.....-A?

On 156 acres, on Tenmile Run.

Elevation, 1068' L.

Date of completion, etc., not given.

10" casing, 138'; 8 $\frac{1}{4}$ " 1040'; 6 $\frac{5}{8}$ " 1972'; all left in.

Casing leaked at 1625' - ran 2 packers on 4-7/8" casing -  
top of packer at 1575'.

Gas well. Record to Dept. of Mines stamped March 16, 1951.

Record to RCT from Mrs. Griffith June 28, 1951. Old File No. 608.

	Top.	Bottom.
Gas	2051	- ....
Total depth		2070



STATE OF WEST VIRGINIA  
DEPARTMENT OF MINES  
OIL AND GAS DIVISION

608

Permit No. 792 690-A

# WELL RECORD

~~Oil or Gas Well~~ (KIND)


Company Valley Steel Products Company  
 Address St. Louis, Mo.  
 Farm R. F. Rice Acres 156  
 Location (waters) Termile Run  
 Well No. 4 Elev. 1086'  
 District Ellsworth County Tyler  
 The surface of tract is owned in fee by \_\_\_\_\_  
 Address \_\_\_\_\_  
 Mineral rights are owned by \_\_\_\_\_  
 Address \_\_\_\_\_  
 Drilling commenced \_\_\_\_\_  
 Drilling completed \_\_\_\_\_  
 Date Shot \_\_\_\_\_ From \_\_\_\_\_ To \_\_\_\_\_  
 With \_\_\_\_\_  
 Open Flow \_\_\_\_\_ /10ths Water in \_\_\_\_\_ Inch  
 \_\_\_\_\_ /10ths Merc. in \_\_\_\_\_ Inch  
 Volume \_\_\_\_\_ Cu. Ft.  
 Rock Pressure \_\_\_\_\_ lbs. \_\_\_\_\_ hrs.  
 Oil \_\_\_\_\_ bbls., 1st 24 hrs.  
 Fresh water \_\_\_\_\_ feet \_\_\_\_\_ feet  
 Salt water \_\_\_\_\_ feet \_\_\_\_\_ feet

Casing and Tubing	Used in Drilling	Left in Well	Packers
Size			Kind of Packer
16			
13			
10	138'	138'	Size of
8 1/4	1040'	1040'	
6 5/8	1972'	1972'	Depth set
5 3/16			
3			Perf. top
2			Perf. bottom
Liners Used			Perf. top
			Perf. bottom

CASING CEMENTED \_\_\_\_\_ SIZE \_\_\_\_\_ No. Ft. \_\_\_\_\_ Date \_\_\_\_\_

COAL WAS ENCOUNTERED AT \_\_\_\_\_ FEET \_\_\_\_\_ INCHES  
 \_\_\_\_\_ FEET \_\_\_\_\_ INCHES \_\_\_\_\_ FEET \_\_\_\_\_ INCHES  
 \_\_\_\_\_ FEET \_\_\_\_\_ INCHES \_\_\_\_\_ FEET \_\_\_\_\_ INCHES

Formation	Color	Hard or Soft	Top	Bottom	Oil, Gas or Water	Depth Found	Remarks
Gas				2051'			
Total Depth				2070'			
							Casing leaked at 1625' - ran 2 packers on 4-7/8" casing - top of packer at 1575'

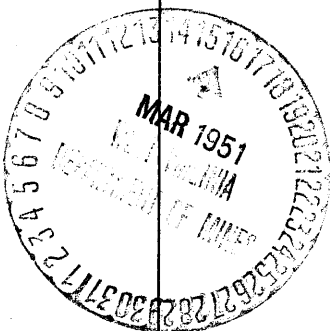

97er JUN 28 1951