


Latitude

39 35

00 18

Longitude

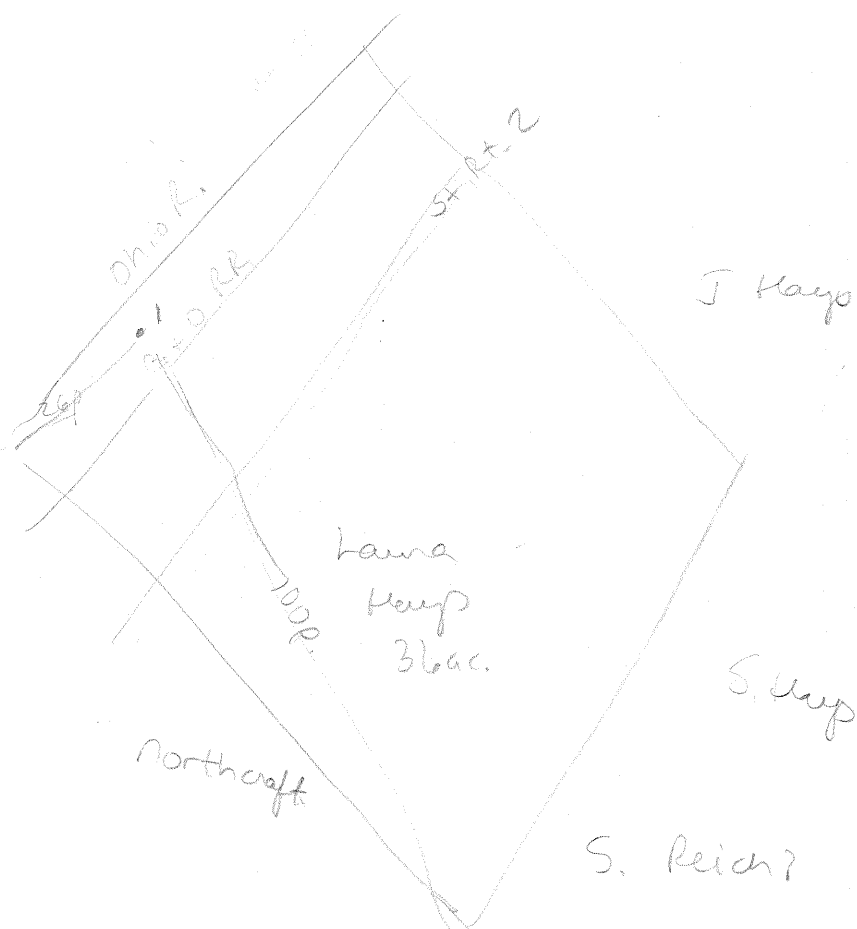

Topo Location

7.5' Loc. \_\_\_\_\_ 15' Loc. N 3.55  
 \_\_\_\_\_ (calc.) 2.25W

Company JC Powell

Farm Laura Hays 1 (36 acres)

15' Quad New Matamoros SE  
(sec.)

7.5' Quad \_\_\_\_\_

District Union

TO-est. 1700 - Big Injun

WELL LOCATION PLAT

County 095 Permit 30720