

Latitude

3930

5018

→ 7.5' Loc
Kla
9/10/95

Longitude

Topo Location

7.5' Loc. 1.195 15' Loc. 1.195
0.37W (calc.) 0.37W

Company _____

Farm _____

15' Quad St Marys NC
(sec.) _____

7.5' Quad Bens Run _____

District Union _____

WELL LOCATION PLAT

County 095 Permit 30724

St Margs nc



677

STATE OF WEST VIRGINIA
DEPARTMENT OF MINES
OIL AND GAS DIVISION

WELL RECORD

oil
Oil or Gas Well **Depleted**
(KIND)

Permit No. TYL-724-A


Company DePuy Brothers
Address C/O George M. DePuy, Friendly W. Va.
Farm Rebecca Parker Acres 40
Location (waters) none
Well No. 1 Elev. _____
District Union County Tyler
The surface of tract is owned in fee by Rebecca Parker
Address Friendly W. Va
Mineral rights are owned by same
Address _____
Drilling commenced Before 1929
Drilling completed _____
Date Shot no record From _____ To _____
With no record

Casing and Tubing	Used in Drilling	Left in Well	Packers
Size			
16			Kind of Packer _____
13			
10	130'	pulled	Size of _____
8 1/4	580'	pulled	
6 5/8	1058,	to be pulled	Depth set _____
5 3/16			
3			Perf. top _____
2			Perf. bottom _____
Liners Used			Perf. top _____
			Perf. bottom _____

Open Flow /10ths Water in no record Inch
/10ths Merc. in no record Inch
Volume no record Cu. Ft.
Rock Pressure no record lbs. hrs.
Oil 10 to 12 bbls., 1st 24 hrs.
Fresh water none recorded feet feet
Salt water none feet feet

CASING CEMENTED none SIZE _____ No. Ft. _____ Date _____
COAL WAS ENCOUNTERED AT _____ FEET _____ INCHES
none FEET _____ INCHES FEET _____ INCHES
_____ FEET _____ INCHES FEET _____ INCHES

Formation	Color	Hard or Soft	Top	Bottom	Oil, Gas or Water	Depth Found	Remarks
Sand			1418'	1456'	Oil	1456	Kefner In jun Total Dep.
Sand			1476'	1500			
Shale			1500'	1518'			

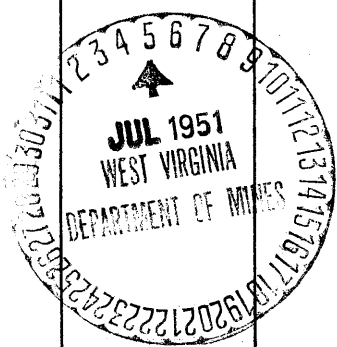

(Over) AUG 27 1951

Formation	Color	Hard or Soft	Top	Bottom	Oil, Gas or Water	Depth Found	Remarks

JUN 29 1951

Date _____, 19____

APPROVED  _____, Owner

By _____ (Title)