

Latitude

39 35

80 57 30

→ 7.5' loc
da 9/1/95

Longitude

Topo Location

7.5' Loc. 0.57S 15' Loc. 0.57S
0.67W (calc.) 2.89W

Company _____

Farm McCoy Heirs 10

15' Quad New Martinsville SW
(sec.)

7.5' Quad Paden City

District Lincoln

WELL LOCATION PLAT

County 095 Permit 30772

10
McCOY HEIRS NO. 20 WELL.

7922

Lincoln District, Tyler County, W. Va.
By St. Marys Pipe & Supply Co., St. Marys, W. Va.
Abandoned under permit Rit-.....-A?
On 216 acres.
Elevation,' L.
Surface and minerals owned by McCoy Heirs, Sistersville, W. Va.
Date of completion, etc., not given.
10" casing, 80'; 8 $\frac{1}{4}$ ", 380'; 6 $\frac{5}{8}$ ", 1071'; all left in.
Oil? well. Record to Dept. of Mines stamped April 7, 1952.
Record to RCT from Mrs. Griffith Dec. 2, 1952. O.F.No.672.

	Top.	Bottom.
Struck sand	1467	
Depth of well		1511
Drilled deeper to		1546

Inj



STATE OF WEST VIRGINIA
DEPARTMENT OF MINES
OIL AND GAS DIVISION

597

WELL RECORD

Permit No. TYL-972-A

Oil or Gas Well _____ (KIND)


Company St Marys Pipe & Supply Company
 Address St Marys W.Va.
 Farm McCoy Heirs Acres 214
 Location (waters) _____
 Well No. Ten Elev. _____
 District Lincoln County Tyler
 The surface of tract is owned in fee by McCoy Heirs
 Address Sistersville W.Va.
 Mineral rights are owned by McCoy Heirs
 Address Sistersville W.Va.
 Drilling commenced _____
 Drilling completed _____
 Date Shot _____ From _____ To _____
 With _____
 Open Flow _____ /10ths Water in _____ Inch
 _____ /10ths Merc. in _____ Inch
 Volume _____ Cu. Ft.
 Rock Pressure _____ lbs. _____ hrs.
 Oil _____ bbls., 1st 24 hrs.
 Fresh water _____ feet _____ feet
 Salt water _____ feet _____ feet

Casing and Tubing	Used in Drilling	Left in Well	Packers
Size			
16			Kind of Packer
13			
10	<u>80'</u>	<u>80'</u>	Size of
8 1/4	<u>380'</u>	<u>380'</u>	
6 5/8	<u>1071'</u>	<u>1071'</u>	Depth set
5 3/16			
3			Perf. top
2			Perf. bottom
Liners Used			Perf. top
			Perf. bottom

CASING CEMENTED _____ SIZE _____ No. Ft. _____ Date _____

COAL WAS ENCOUNTERED AT _____ FEET _____ INCHES
 _____ FEET _____ INCHES FEET _____ INCHES
 _____ FEET _____ INCHES FEET _____ INCHES

Formation	Color	Hard or Soft	Top	Bottom	Oil, Gas or Water	Depth Found	Remarks
		<u>Struck Sand 1457'</u>					
		<u>Depth of Well 1511'</u>					
		<u>Drilled Depper 1546'</u>					

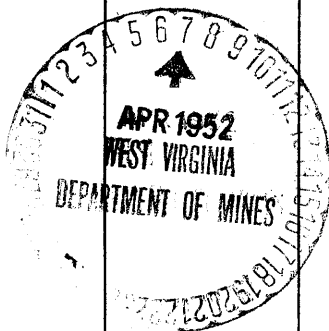

460 2 1952