
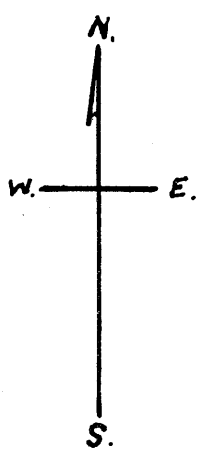


Latitude 39° 30'

Longitude 81° 00'

⊕ 3.52 W
2.26 S

Selman Wells.

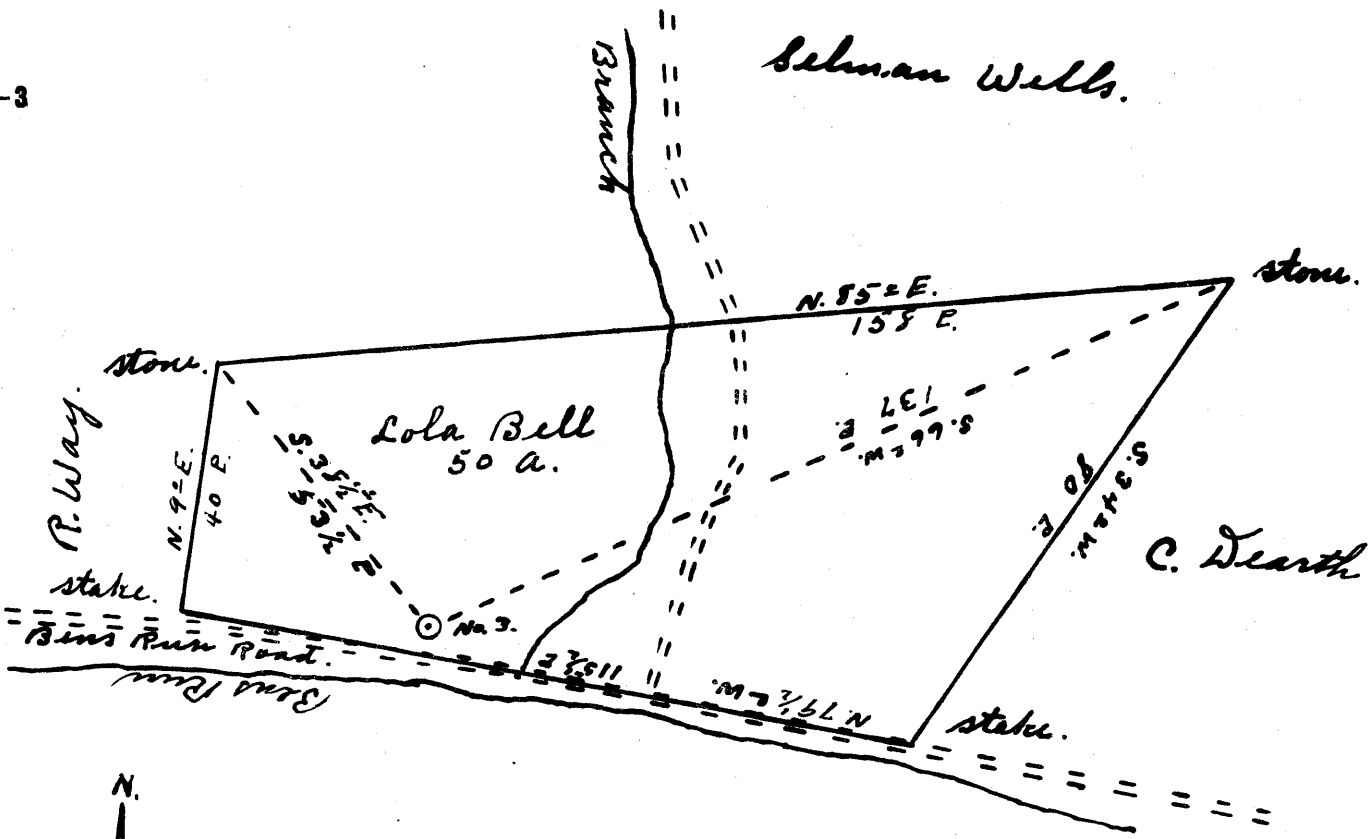

W.C. Bell.

3.58 W
2.27 S

New Location...
 Drill Deeper...
 Abandonment...

✓ FEB 9 1953

Company Chas. F. Smith
 Address 304 Chelsea St. Sistersville W. Va.
 Farm Lola Bell.
 Tract _____ Acres 50 Lease No. _____
 Well (Farm) No. 3 Serial No. _____
 Elevation (Spirit Level) 790'
 Quadrangle St. Marys
 County Tyler District Union
 Engineer Robert R. Anderson
By Jno. Triplett, Surveyor.
 Engineer's Registration No. 296
 File No. _____ Drawing No. _____
 Date Jan. 8, 1953 Scale 1" = 30 P

STATE OF WEST VIRGINIA
 DEPARTMENT OF MINES
 OIL AND GAS DIVISION
 CHARLESTON

WELL LOCATION MAP
 FILE NO. JYL-817-A

+ Denotes location of well on United States Topographic Maps, scale 1 to 62,500, latitude and longitude lines being represented by border lines as shown.

- Denotes one inch spaces on border line of original tracing.



704

STATE OF WEST VIRGINIA
DEPARTMENT OF MINES
OIL AND GAS DIVISION

WELL RECORD

Permit No. 817-A


Oil or Gas Well (KIND)

Company Charles F. Smith
 Address 304 Chelsea St. Sistersville, W. Va.
 Farm 4ola Bell Acres 50
 Location (waters) _____
 Well No. 3 Elev. 790
 District Union County Tyler
 The surface of tract is owned in fee by _____
 Address _____
 Mineral rights are owned by _____
 Address _____
 Drilling commenced _____
 Drilling completed _____
 Date Shot _____ From _____ To _____
 With _____
 Open Flow /10ths Water in _____ Inch
/10ths Merc. in _____ Inch
 Volume _____ Cu. Ft.
 Rock Pressure _____ lbs. _____ hrs.
 Oil _____ bbls., 1st 24 hrs.
 Fresh water _____ feet _____ feet
 Salt water _____ feet _____ feet

Casing and Tubing	Used in Drilling	Left in Well	Packers
Size			
16			Kind of Packer
13			
10			Size of
8 1/4			
6% <u>1/4</u>	<u>No record given</u>		Depth set
5 3/16			
3 <u>4 7/8</u>	<u>713</u>	<u>713</u>	Perf. top
2			Perf. bottom
Liners Used			Perf. top
			Perf. bottom

CASING CEMENTED _____ SIZE _____ No. Ft. _____ Date _____
 COAL WAS ENCOUNTERED AT _____ FEET _____ INCHES
 _____ FEET _____ INCHES FEET _____ INCHES
 _____ FEET _____ INCHES FEET _____ INCHES

Formation	Color	Hard or Soft	Top	Bottom	Oil, Gas or Water	Depth Found	Remarks
Co ^w run			725	751	oil	725	All given on record

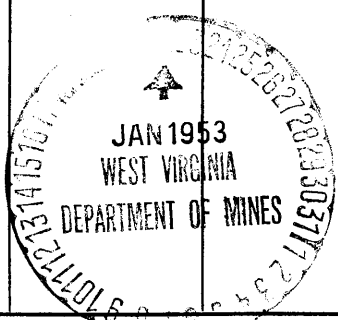

(Over) JUN 10 1953