
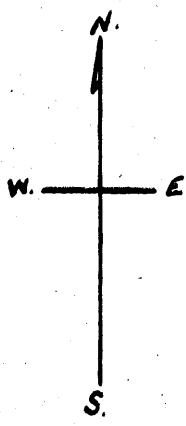


Latitude 39° 35'

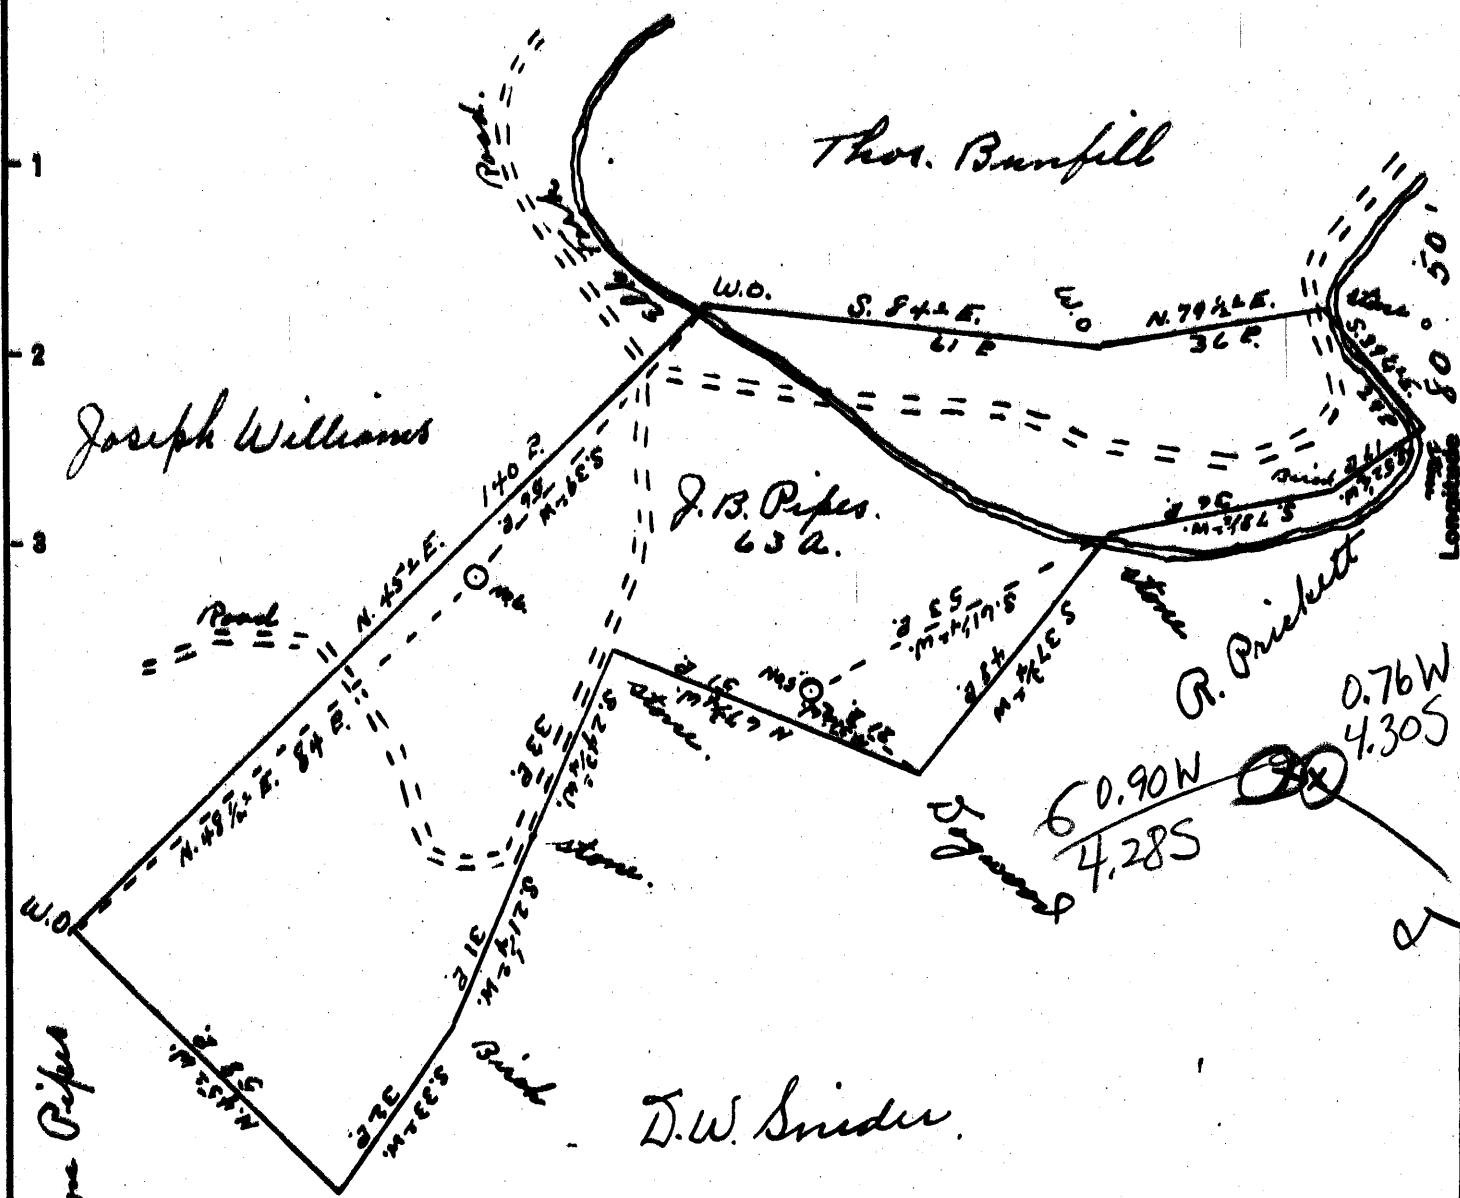

# 5	0.78 W 4.30 S
# 6	0.92 W 4.36 S

New Location...
 Drill Deeper.....
 Abandonment.....

FEB 23 1953

Company Reno Oil Company
 Address Sistersville W. Va.
 Farm J. B. Pipes
 Tract _____ Acres 63 Lease No. _____
 Well (Farm) No. 576 Serial No. _____
 Elevation (Spirit Level) No. 5716 No. 6 980
 Quadrangle New Martinsville
 County Tyler District Ellsworth
 Engineer Robert R. Anderson
 By Jno Triplett, Surveyor
 Engineer's Registration No. 296
 File No. _____ Drawing No. _____
 Date Nov. 7, 1952 Scale 1" = 30 P.

STATE OF WEST VIRGINIA
 DEPARTMENT OF MINES
 OIL AND GAS DIVISION
 CHARLESTON

WELL LOCATION MAP
 FILE NO. JYL-819-A-#5
JYL-820-A-#6

+ Denotes location of well on United States Topographic Maps, scale 1 to 62,500, latitude and longitude lines being represented by border lines as shown.
 - Denotes one inch spaces on border line of original tracing.

STATE OF WEST VIRGINIA
DEPARTMENT OF MINES
OIL AND GAS DIVISION

713

WELL RECORD

Permit No. 819A


Oil or Gas Well Oil
(Kind)

Company Reno Oil Company,
Address Sistersville, W. Va.
Farm J. B. Pipes Acres 63
Location (waters).....
Well No. Five Elev. 716
District Ellsworth County Tyler
The surface of tract is owned in fee by.....
Address.....
Mineral rights are owned by Pipes Heirs
Address.....
Drilling commenced.....
Drilling completed.....
Date shot..... Depth of shot.....
Open Flow /10ths Water in..... Inch
/10ths Merc. in..... Inch
Volume..... Cu. Ft.
Rock Pressure..... lbs..... hrs.
Oil..... bbls., 1st 24 hrs.
Fresh water..... feet..... feet
Salt water..... feet..... feet

Casing and Tubing	Used in Drilling	Left in Well	Packers
Size			
16.....			Kind of Packer.....
13.....			
10.....			Size of.....
8 3/4.....	<u>895</u>		
6 5/8.....	<u>1,606</u>		Depth set.....
5 3/16.....			
3.....			Perf. top.....
2.....			Perf. bottom.....
Liners Used.....			Perf. top.....
			Perf. bottom.....

CASING CEMENTED..... SIZE..... No. Ft..... Date.....
COAL WAS ENCOUNTERED AT..... FEET..... INCHES
..... FEET..... INCHES..... FEET..... INCHES
..... FEET..... INCHES..... FEET..... INCHES

Formation	Color	Hard or Soft	Top	Bottom	Oil, Gas or Water	Depth Found	Remarks
1st Cow Run			790				
Salt Sand			1145				
Lime Stone			1605				
Big Injun			1655				
First Pay			1659				
Total Depth			1677				

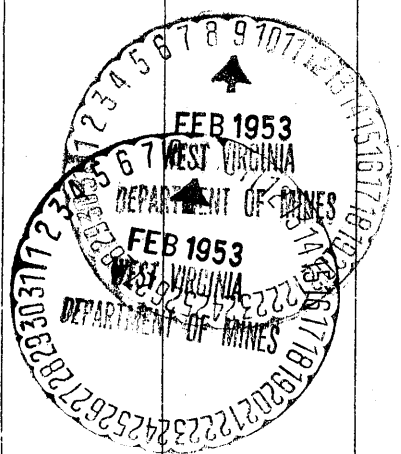

Formation	Color	Hard or Soft	Top	Bottom	Oil, Gas or Water	Depth Found	Remarks

Date..... **February 7th**, 19..... **53**

APPROVED..... **RENO OIL COMPANY,**, Owner

By..... *Arthur Davis*,
 (Title) **Asst. Treas.**