

Latitude 39° 35'

Longitude 80° 50'

John B. Pipes

John B. Pipes


Waynesburg and Middlebourn Road
Henry A. Summers Birch

D. W. Snider
30 acres

E. P. Snider 0.77W
4.42S

Sophia Snider

# 1	0.84W
	4.41S
# 2	0.77W
	4.51S

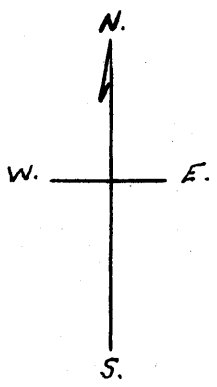

New Location
 Drill Deeper
 Abandonment

APR 7 1953

Company Reno Oil Company
 Address Sistersville W. Va.
 Farm D. W. Snider
 Tract _____ Acres 30 Lease No. _____
 Well (Farm) No. 1 & 2 Serial No. _____
 Elevation (Spirit Level) No. 1, 840' No 2, 720'
 Quadrangle New Martinsville
 County Tyler District Ellsworth
 Engineer Robert R. Anderson
By Jno Triplett, Surveyor.
 Engineer's Registration No. 296
 File No. _____ Drawing No. _____
 Date Nov. 5, 1952 Scale 1" = 20 F.

STATE OF WEST VIRGINIA
 DEPARTMENT OF MINES
 OIL AND GAS DIVISION
 CHARLESTON

WELL LOCATION MAP
 FILE NO. JYL-825-A-#1
JYL-826-A-#2

+ Denotes location of well on United States Topographic Maps, scale 1 to 62,500, latitude and longitude lines being represented by border lines as shown.
 - Denotes one inch spaces on border line of original tracing.