


Latitude 38° 35'

Longitude 80° 55'

(+) 4.07 W.
1.11 S

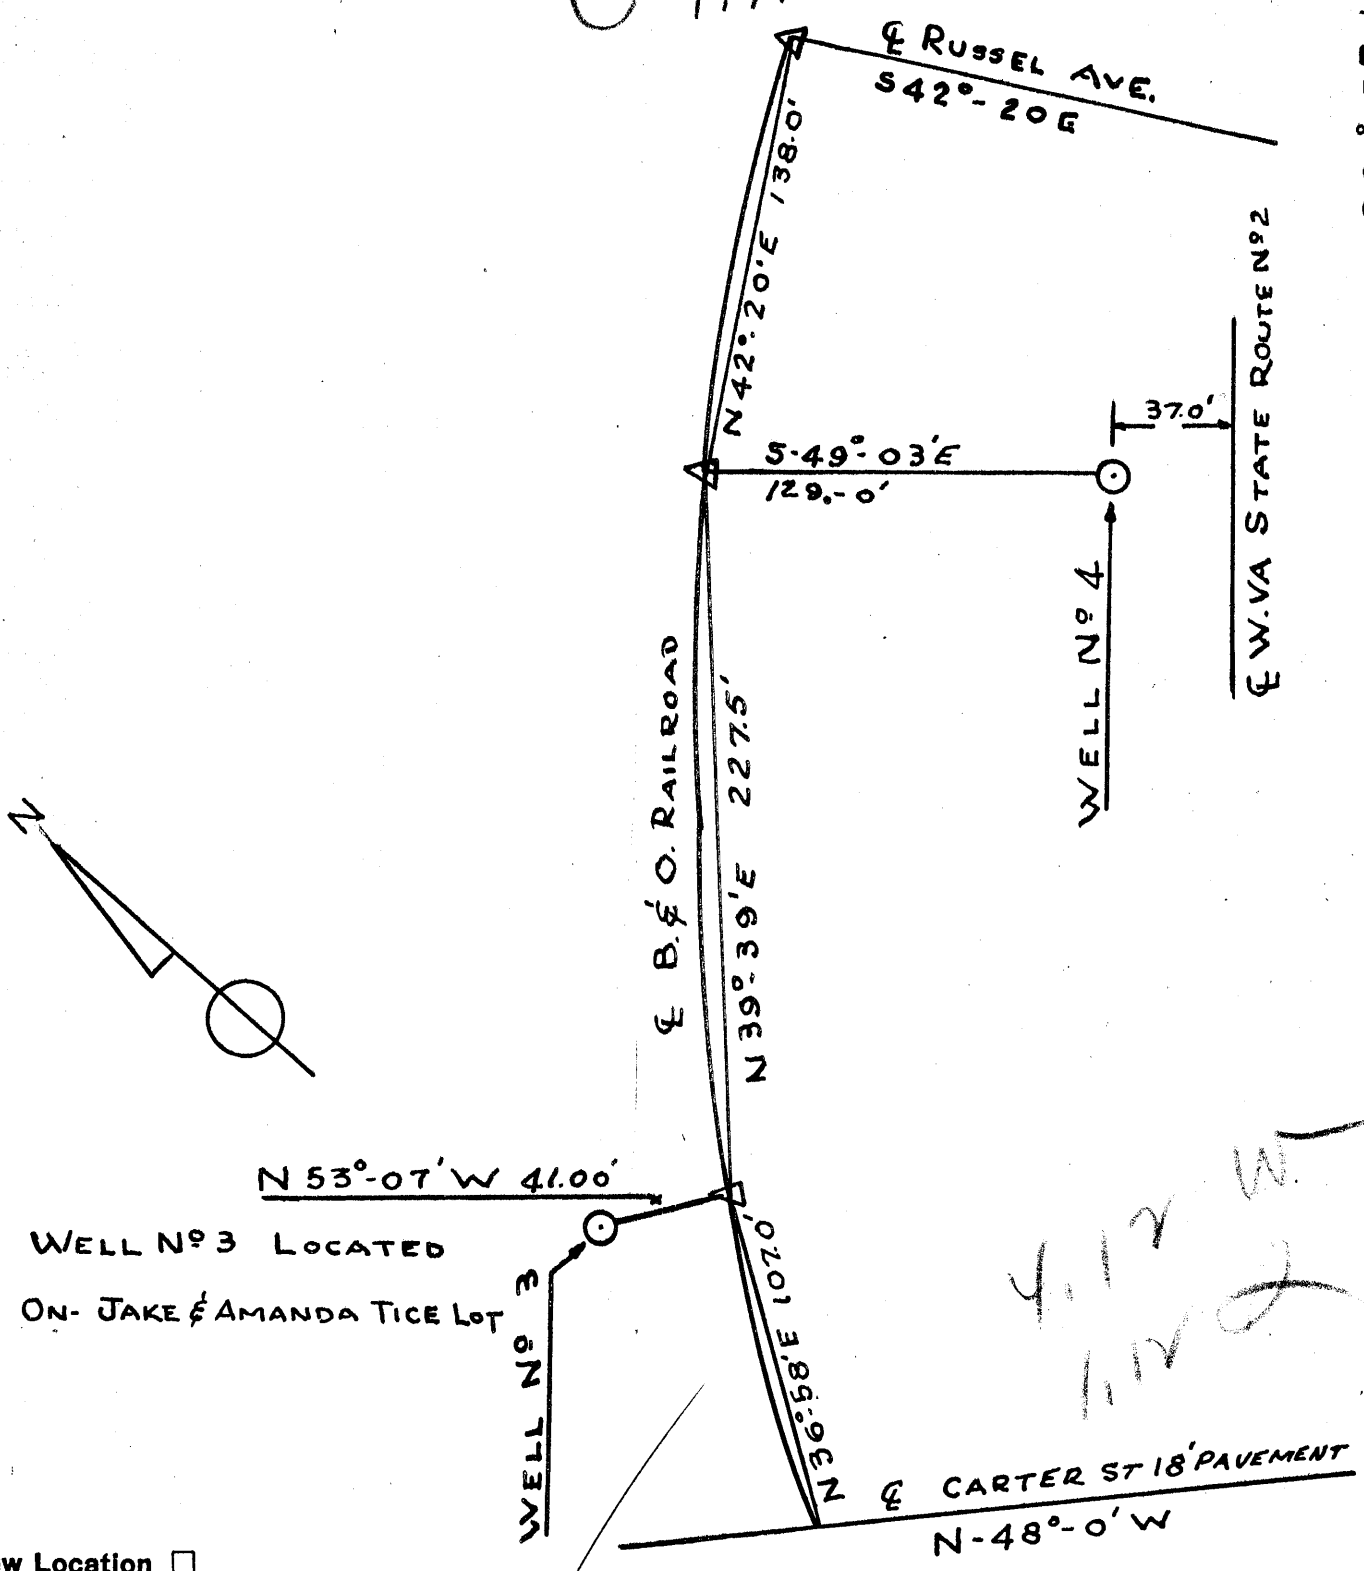

WELL N^o 3 LOCATED
ON- JAKE & AMANDA TICE LOT

4.12 W.
1.11 S

New Location...
Drill Deeper.....
Abandonment.....

NOV 7 1955

Company MACKAY & WHITE
 Address RAVEN ROCK W.VA.
 Farm CITY LOT-JAKE & AMANDA TICE
 Tract _____ Acres 0.30 Lease No. _____
 Well (Farm) No. 3 Serial No. _____
 Elevation (Spirit Level) 641.5
 Quadrangle NEW MARTINSVILLE W.VA.
 County TYLER District LINCOLN
 Engineer E. M. Coe
 Engineer's Registration No. 889
 File No. _____ Drawing No. _____
 Date MAR 17. 1955 Scale 1" = 60'-00"

STATE OF WEST VIRGINIA
 DEPARTMENT OF MINES
 OIL AND GAS DIVISION
 CHARLESTON

WELL LOCATION MAP
 FILE NO. JYL-866-A

+ Denotes location of well on United States Topographic Maps, scale 1 to 62,500, latitude and longitude lines being represented by border lines as shown.

- Denotes one inch spaces on border line of original tracing.

JAKE & AMANDA TICE No. 3 - MACKAY & WHITE - TYL-866-A



STATE OF WEST VIRGINIA
DEPARTMENT OF MINES
OIL AND GAS DIVISION

755

New Martinsville
826 A

WELL RECORD

Permit No. 741 826 A

Oil or Gas Well (KIND)


Company Mackey & White
Address Raven Rock, W. Va.
Farm G.B. Stocking hrs. Acres lot
Location (waters) Ohio River
Well No. 3 Elev. 641.5
District Madison County Tyler
The surface of tract is owned in fee by Jake & Amanda Rice Address Sistersville, W. Va.
Mineral rights are owned by G.B. Stocking hrs. Address Sistersville, W. Va.
Drilling commenced _____
Drilling completed 1901
Date Shot _____ From _____ To _____
With _____

Casing and Tubing	Used in Drilling	Left in Well	Packers
Size			Kind of Packer
16			
13			
10			Size of
8 1/4			
6 1/4		1035	Depth set
5 1/8		1090	
3			Perf. top
2	Tubing Pulled		Perf. bottom
Liners Used			Perf. top
			Perf. bottom

Open Flow _____ /10ths Water in _____ Inch
_____ /10ths Merc. in _____ Inch
Volume _____ Cu. Ft.
Rock Pressure _____ lbs. _____ hrs.
Oil _____ bbls., 1st 24 hrs.
Fresh water _____ feet _____ feet
Salt water _____ feet _____ feet

CASING CEMENTED _____ SIZE _____ No. Ft. _____ Date _____
COAL WAS ENCOUNTERED AT _____ FEET _____ INCHES
_____ FEET _____ INCHES FEET _____ INCHES
_____ FEET _____ INCHES FEET _____ INCHES

Formation	Color	Hard or Soft	Top	Bottom	Oil, Gas or Water	Depth Found	Remarks
		Big Injun Sand		1405			
		Depth of Well		1447			

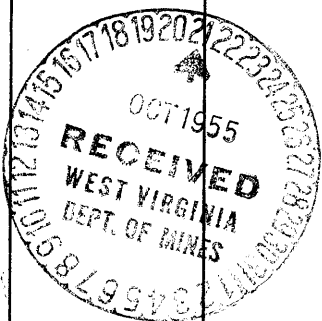

Formation	Color	Hard or Soft	Top	Bottom	Oil, Gas or Water	Depth Found	Remarks

Date Oct 19, 1955

APPROVED E. J. White, Owner

By Martin
(Title)