


Latitude 39° 30'

Longitude 80° 40'

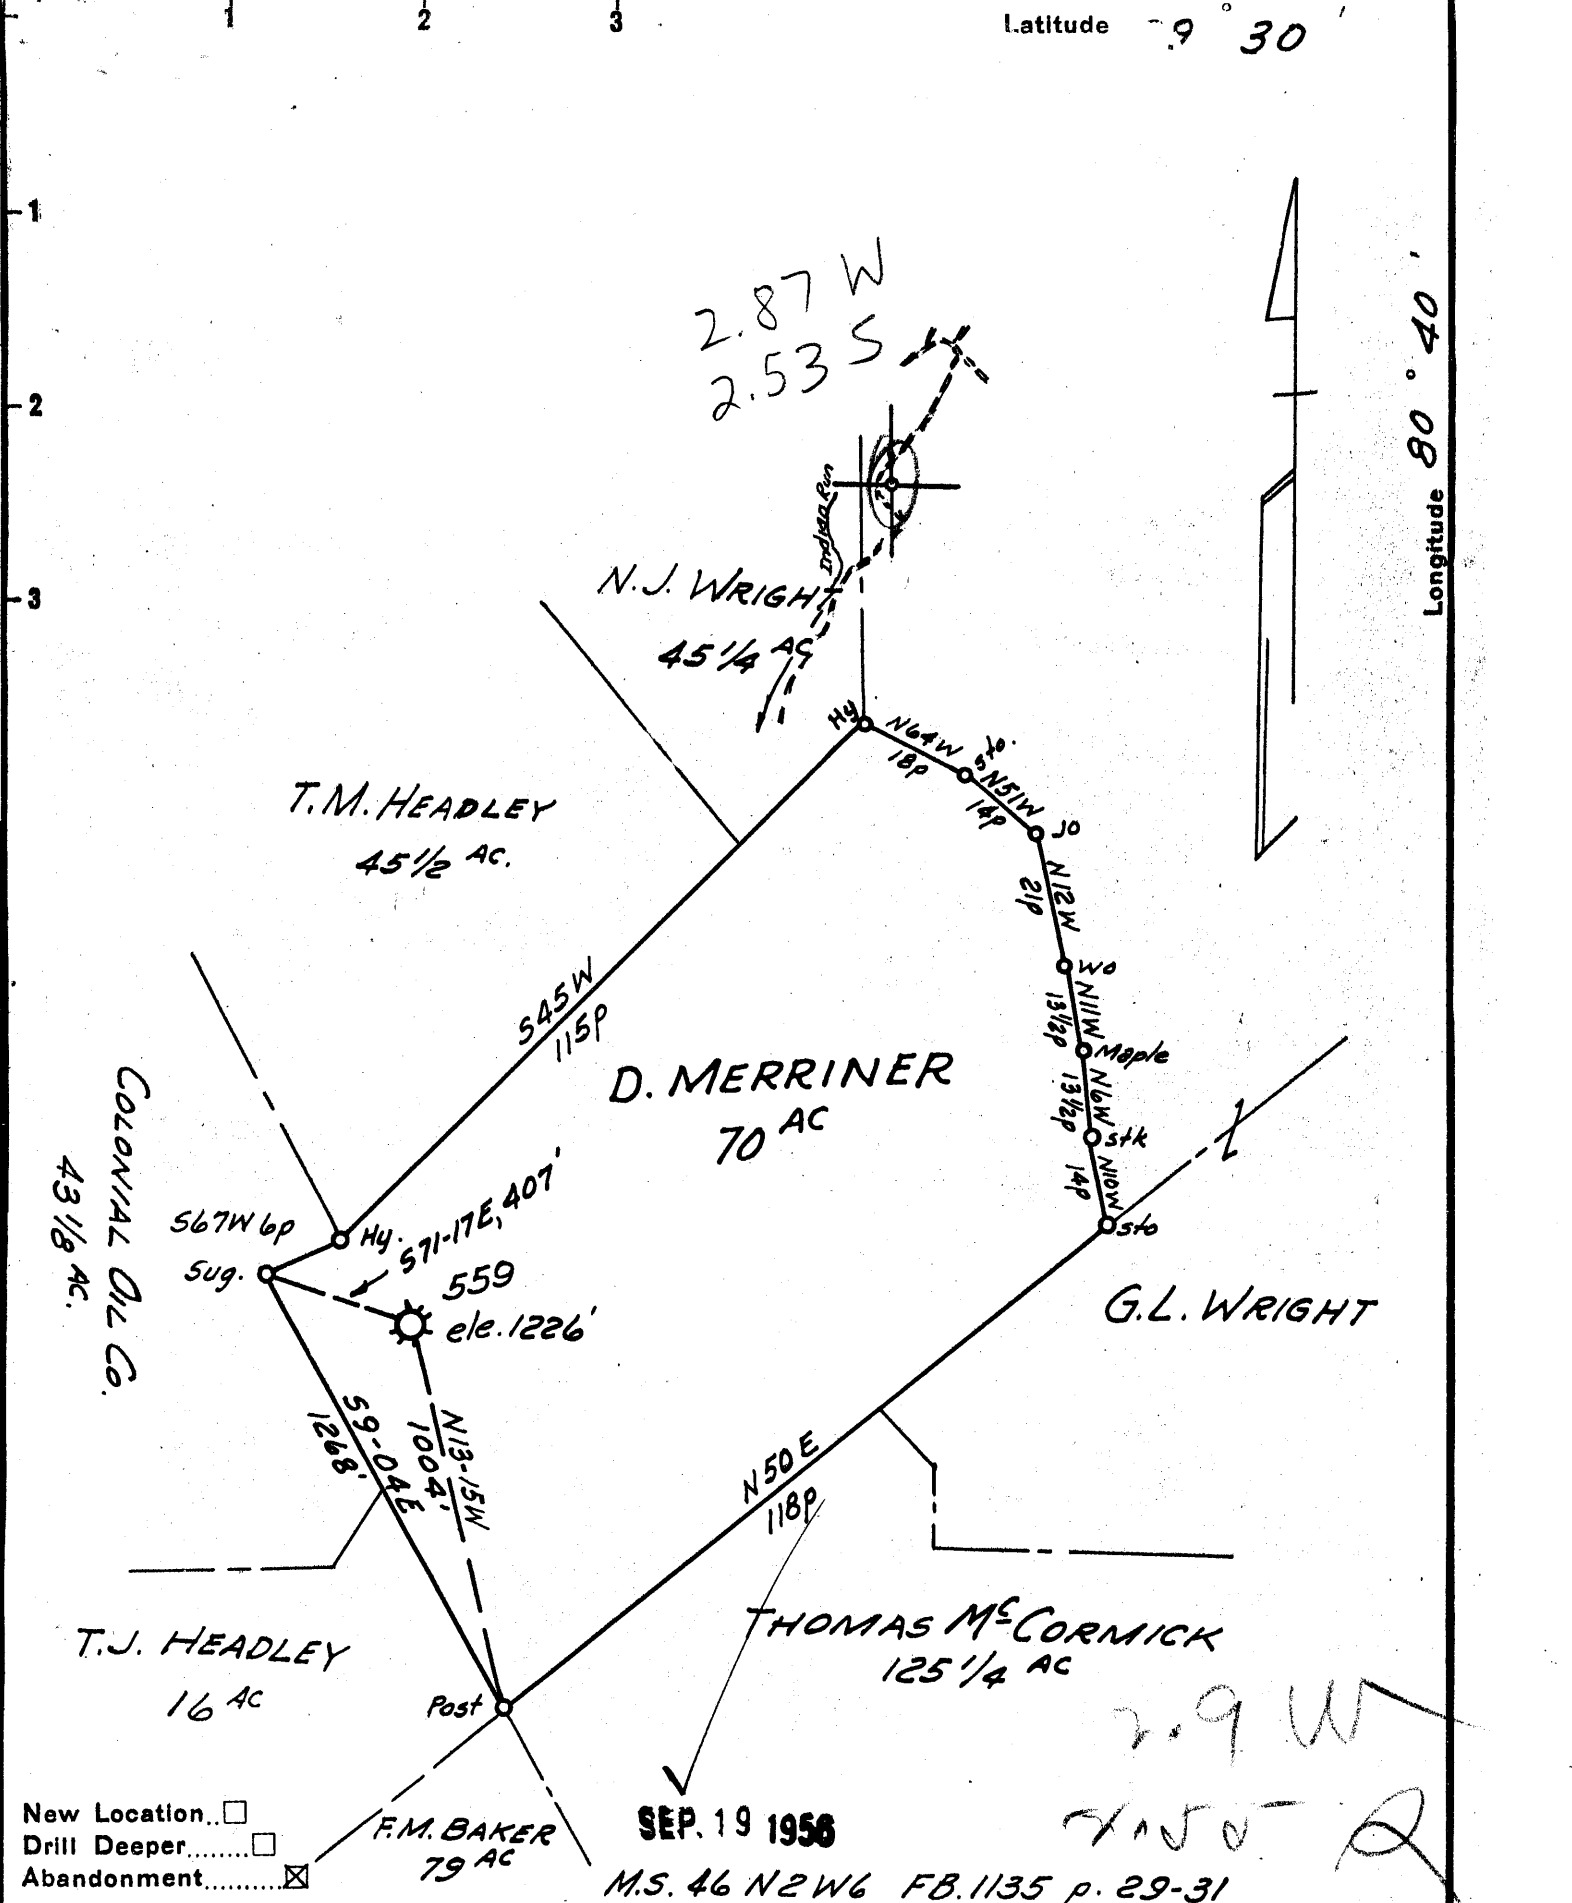

- New Location
- Drill Deeper
- Abandonment

Company HOPE NATURAL GAS CO.
 Address CLARKSBURG, W.VA.
 Farm DAVID MERRINER
 Tract Acres 70 Lease No. 4484
 Well (Farm) No. Serial No. 559
 Elevation (Spirit Level) 1226'
 Quadrangle CENTERPOINT
 County TYLER District McFLOY
 Engineer Guy N. Bradley
 Engineer's Registration No. 2425
 File No. Drawing No.
 Date AUG. 23, '56 Scale 1" = 30p

STATE OF WEST VIRGINIA
 DEPARTMENT OF MINES
 OIL AND GAS DIVISION
 CHARLESTON

WELL LOCATION MAP
 FILE NO. JYL-876-A

+ Denotes location of well on United States Topographic Maps, scale 1 to 62,500, latitude and longitude lines being represented by border lines as shown.
 - Denotes one inch spaces on border line of original tracing.

DAVID MERRINER No 559 - HOPE N.G. Co. - TYL-876-A



769

STATE OF WEST VIRGINIA
DEPARTMENT OF MINES
OIL AND GAS DIVISION

Quadrangle Centerpoint

Permit No. 876 A

WELL RECORD

Oil or Gas Well Gas
(KIND)


Company Hope Natural Gas Company
Address Clarksburg, W. Va.
Farm David Merriner Acres 70
Location (waters) _____
Well No. 559 Elev. 1226'
District MCELROY County Tyler
The surface of tract is owned in fee by _____
Address _____
Mineral rights are owned by _____
Address _____

Casing and Tubing	Used in Drilling	Left in Well	Packers
Size			Kind of Packer
16			
13			
10	198	198	Size of
8 1/4			
6 5/8	2221	2221	Depth set
5 3/16	2509	2509	
3			Perf. top
2			Perf. bottom
Liners Used			Perf. top
			Perf. bottom

Drilling commenced Sept. 21, 1900
Drilling completed March 24, 1901
Date Shot 5-28-26 From Gordon Sand
With 20 Qts.
Open Flow /10ths Water in _____ Inch
/10ths Merc. in _____ Inch
Volume Exhausted Cu. Ft.
Rock Pressure _____ lbs. _____ hrs.
Oil _____ bbls., 1st 24 hrs.
Fresh water No Record feet _____ feet
Salt water do feet _____ feet

CASING CEMENTED _____ SIZE _____ No. Ft. _____ Date _____
No Cementing recorded
COAL WAS ENCOUNTERED AT _____ FEET _____ INCHES
948 FEET ? INCHES FEET _____ INCHES
FEET _____ INCHES FEET _____ INCHES

Formation	Color	Hard or Soft	Top	Bottom	Oil, Gas or Water	Depth Found	Remarks
Conductor				16			
Pittsburgh Coal			948	?			
Big Injun Sand			2225	?	Oil in Big Injun @ 2346'		
Stray Sand			3003	?			
Gordon			3012	3025	Gas	3014'	
TOTAL DEPTH				3029'			
Drilled Deeper thru Fourth			3045	3054			
TOTAL DEPTH				3054'	No Gas		

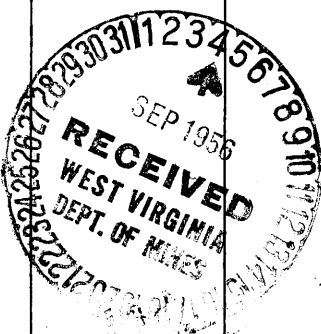

August 30, 1956
Hope Natural Gas Company

MAR 28 1957