

New Location   
 Drill Deeper   
 Abandonment

OCT 22 1957

2.82 W  
 2.90

Company	ELMER HENTHORN
Address	MIDDLEBORNE W.VA.
Farm	CLARK LAZEAR
Tract	1 Acres 65 1/2 Lease No.
Well (Farm) No.	3 Serial No.
Elevation (Spirit Level)	788
Quadrangle	NEW MARTINSVILLE
County	TYLER District ELLSWORTH
Engineer	G.L. McIntire
Engineer's Registration No.	1107
File No.	Drawing No.
Date	5-27-57 Scale 1" = 20 ROP

STATE OF WEST VIRGINIA  
 DEPARTMENT OF MINES  
 OIL AND GAS DIVISION  
 CHARLESTON

**WELL LOCATION MAP**  
 FILE NO. JYL-884-R

+ Denotes location of well on United States Topographic Maps, scale 1 to 62,500, latitude and longitude lines being represented by border lines as shown.

- Denotes one inch spaces on border line of original tracing.

CLARK LAZEAR No. 3 - ELMER HENTHORN - JYL-884-R



75

STATE OF WEST VIRGINIA  
DEPARTMENT OF MINES  
OIL AND GAS DIVISION

WELL RECORD

Oil or Gas Well Oil  
(KIND)

New Mintonsville  
Permit No. 884A


1957?

Company EMOR E. HENTHORN  
 Address Middlebourne W. Va.  
 Farm CLARK LAZAR Acres 65 1/2  
 Location (waters) \_\_\_\_\_  
 Well No. 3 Elev. 798  
 District ELLSWORTH County TYLER  
 The surface of tract is owned in fee by \_\_\_\_\_  
 Address \_\_\_\_\_  
 Mineral rights are owned by \_\_\_\_\_  
 Address \_\_\_\_\_  
 Drilling commenced \_\_\_\_\_  
 Drilling completed June 20, 1906  
 Date Shot June 3, 1906 From 1674 To 1681  
 With 50 quarts of Lisorene  
 Open Flow \_\_\_\_\_ /10ths Water in \_\_\_\_\_ Inch  
 \_\_\_\_\_ /10ths Merc. in \_\_\_\_\_ Inch  
 Volume \_\_\_\_\_ Cu. Ft.  
 Rock Pressure \_\_\_\_\_ lbs. \_\_\_\_\_ hrs.  
 Oil \_\_\_\_\_ bbls., 1st 24 hrs.  
 Fresh water \_\_\_\_\_ feet \_\_\_\_\_ feet  
 Salt water \_\_\_\_\_ feet \_\_\_\_\_ feet

Casing and Tubing	Used in Drilling	Left in Well	Packers
Size			
16 <u>unknown</u>	<u>unknown</u>		Kind of Packer
13 "			
10 "			Size of
8 1/2			
6 5/8 <u>1409</u>	<u>1409'</u>	<u>1409'</u>	Depth set
5 3/16			
3			Perf. top
2			Perf. bottom
Liners Used			Perf. top
			Perf. bottom

CASING CEMENTED NONE SIZE \_\_\_\_\_ No. Ft. \_\_\_\_\_ Date \_\_\_\_\_  
 COAL WAS ENCOUNTERED AT 1657 FEET \_\_\_\_\_ INCHES  
1674 FEET \_\_\_\_\_ INCHES FEET \_\_\_\_\_ INCHES  
 FEET \_\_\_\_\_ INCHES FEET \_\_\_\_\_ INCHES

Formation	Color	Hard or Soft	Top	Bottom	Oil, Gas or Water	Depth Found	Remarks
<u>UNKNOWN</u>							<u>No record of well (total depth - see sheet record)</u>

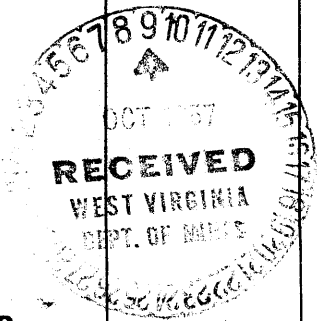

DEC 20 1958

(Over)

