


1  
2  
3

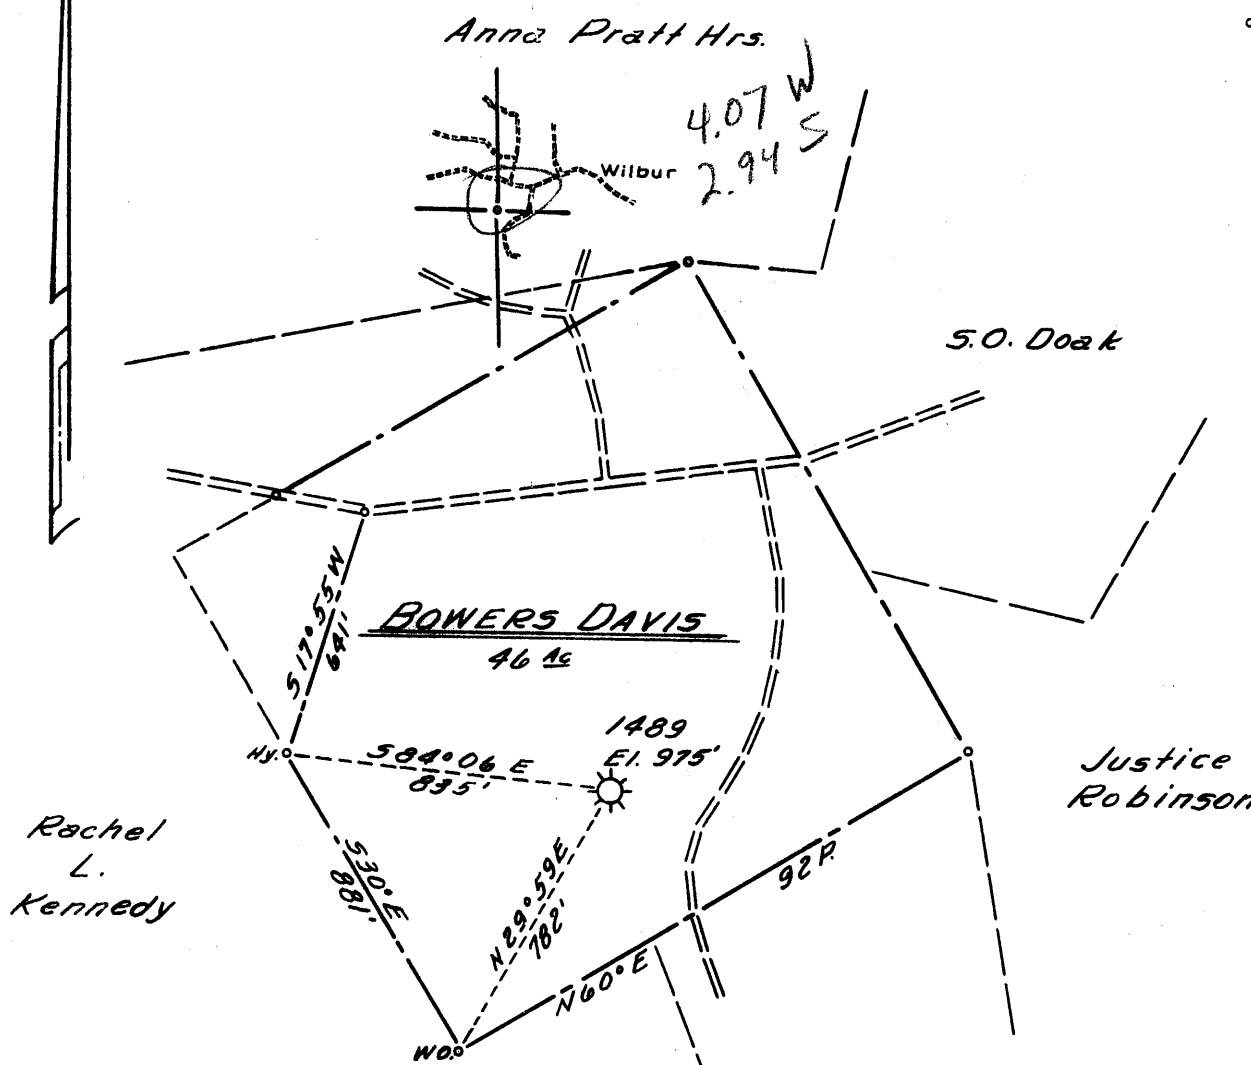

Minimum Error of Closure... 1" IN. 500'

Source of Elevation... MEY. FROM RD. MARKS AT WILBUR. ELEV. 1970'

"I, the undersigned, hereby certify that this map is correct to the best of my knowledge and belief and shows all the information required by paragraph 6 of the rules and regulations of the oil and gas section of the mining laws of West Virginia."

New Location...   
 Drill Deeper...   
 Abandonment...

Map Sheet 53, 55 W 12, F.B. 1216 P. 39

Company HOPE NATURAL GAS CO.  
 Address CLARKSBURG, W.VA.  
 Farm BOWERS DAVIS  
 Tract \_\_\_\_\_ Acres 46 Lease No. 3305  
 Well (Farm) No. \_\_\_\_\_ Serial No. 1489  
 Elevation (Spirit Level) 975'  
 Quadrangle WEST UNION-EC  
 County TYLER District CENTERVILLE  
 Engineer Guy H. Bradley  
 Engineer's Registration No. 2425  
 File No. \_\_\_\_\_ Drawing No. \_\_\_\_\_  
 Date 11-6-64 Scale 1" = 30 POLES

STATE OF WEST VIRGINIA  
 DEPARTMENT OF MINES  
 OIL AND GAS DIVISION  
 CHARLESTON

**WELL LOCATION MAP**  
 FILE NO. TYL-940-A

+ Denotes location of well on United States Topographic Maps, scale 1 to 62,500, latitude and longitude lines being represented by border lines as shown.

- Denotes one inch spaces on border line of original tracing.