


LATITUDE 39° 25'

LONGITUDE 80° 40'

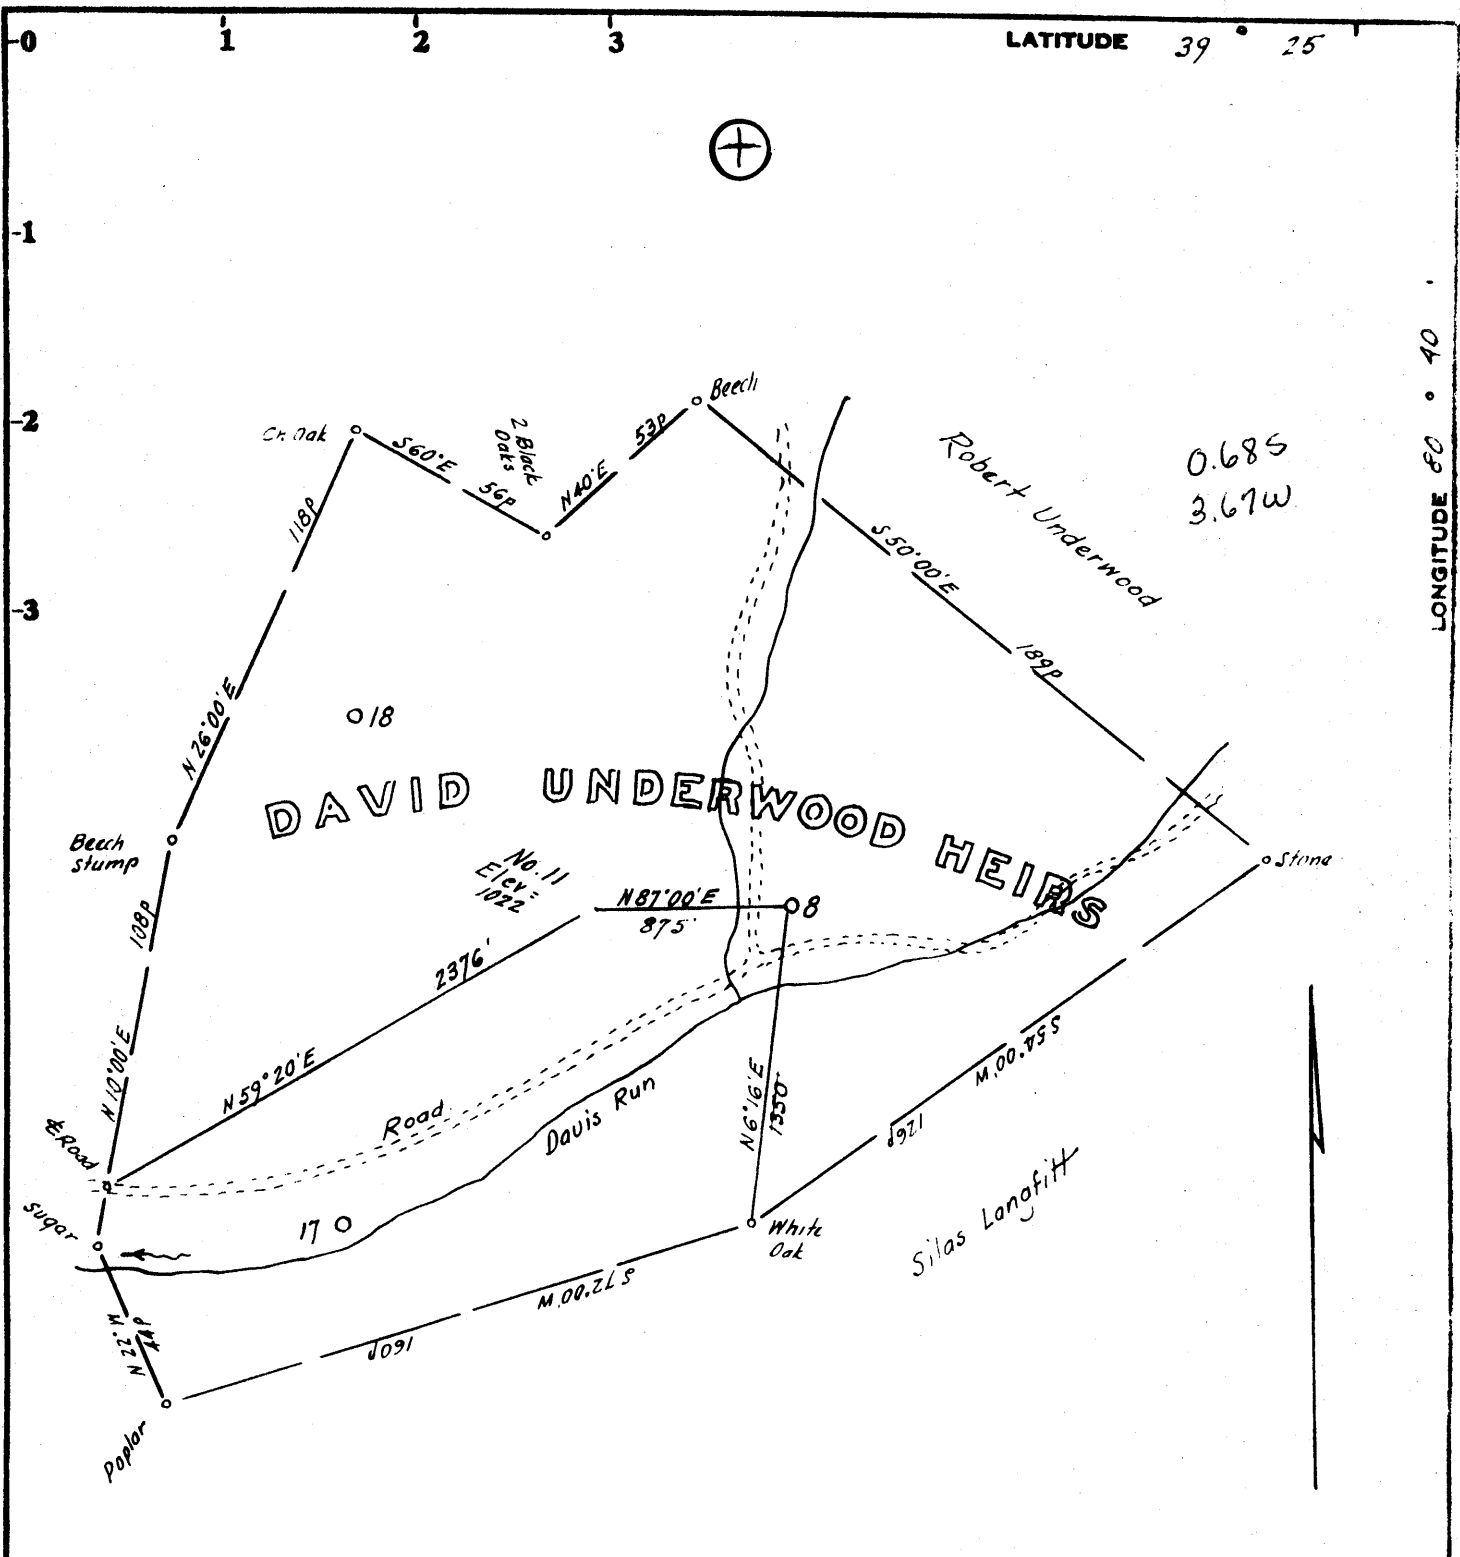

Minimum Error of Closure 1 in 200

Source of Elevation USGS elev at forks of road: 795

- Fracture
- New Location
- Drill Deeper
- Abandonment ISSUED 7/8/75 Map No.

I, the undersigned, hereby certify that this map is correct to the best of my knowledge and belief and shows all the information required by paragraph 6 of the rules and regulations of the oil and gas section of the mining laws of West Virginia.

Signed: W. S. [Signature]
Squares: N S E W

Company	<u>ASSOCIATED MINERALS</u>
Address	<u>225 4th St - Suite 4 East Parkersburg W.Va.</u>
Farm	<u>David Underwood's Heirs</u>
Tract	Acres <u>246</u> Lease No. _____
Well (Farm) No.	<u>Eleven</u> Serial No. _____
Elevation (Spirit Level)	<u>1022</u>
Quadrangle	<u>Centerpoint EC</u>
County	<u>Tyler</u> District <u>McElroy</u>
Engineer	<u>[Signature]</u>
Surveyor	<u>[Signature]</u>
Surveyor's Registration No.	<u>1227</u>
File No.	Drawing No. _____
Date	<u>October 21, 1974</u> Scale <u>1" = 500' = 825'</u>

STATE OF WEST VIRGINIA
DEPARTMENT OF MINES
OIL AND GAS DIVISION
CHARLESTON

WELL LOCATION MAP

FILE NO. TYL-967-A

+ Denotes location of well on United States Topographic Maps, scale 1 to 62,500, latitude and longitude lines being represented by border lines as shown.

- Denotes one inch spaces on border line of original tracing.

47-095