


LATITUDE 39° 32' 30"

LONGITUDE 80° 57' 30"

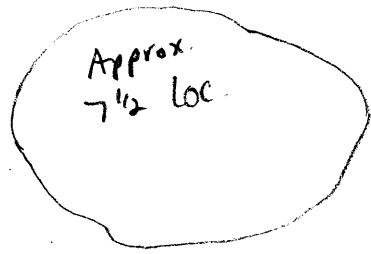

7.5 OGIS topo location

7.5' loc _____ 15' loc _____
(calc.) _____

Company _____

Farm _____

Quad Paden City 7 1/2

County Tyler

District Union

WELL LOCATION MAP

File No. 095-70026 #66 mth
095-70027 #69 Co. Rep
095-70028
095-70029

JOS. F. ARCHER NO. 2 WELL.

70026
Gal. No. 171A (134)

#66 on MTW Co. Rept.

Union District, Tyler County, W. Va.
Heno Oil Co.
Elevation, 655' B.
Oil well.
On Buffalo Run.

7

Big Injan Sand (oil)
Total depth

Top:	Bottom.
1500	1515