


LATITUDE 39° 37' 30"

LONGITUDE 80° 57' 30"

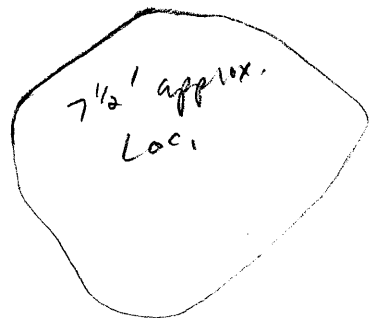

7'5 OGIS topo location

7.5' loc _____ 15' loc _____
 _____ (calc.) _____

Company _____

Farm _____

Quad Paden City 7 1/2'

County Tyler

District Lincoln

WELL LOCATION MAP

File No. 095-70234

Lincoln District, Tyler County, W. Va.
L. J. Brennan.
Upper part of Sistersville field.

No location found

?

	Top.	Bottom.
Cow Run Sand	885	925
Salt Sand	1083	1283
Big Lime	1587	1657
Break	1677	1687
Big Injun Sand (oil, 1690' and 1730')	1687	1790