


LATITUDE 39° 30' 00"

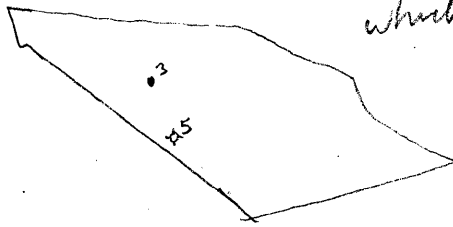

not sure which one ??

LONGITUDE 80° 55' 00"

7'5 OGIS topo location

7.5' loc _____ 15' loc _____
(calc.) _____

Company _____

Farm _____

Quad Middlebourne 7 1/2'

County Tyler

District Ellsworth

WELL LOCATION MAP

File No. 095-70287

J. A. GORRELL NO. 3 (5?) WELL.

Gal. No. 144 (115)

70287

oil
gas
Ellsworth District, Tyler County, W. Va.
Melrose Oil & Gas Co.
Elevation, 715'.
On Gorrell Run.

No Location
Found

Maxton Sand (pay, 1503')
Big Lime
Total depth

Top.	Bottom.
1485	
1516	
	1519