


Plat of the Proposed Location of Well No. One of J.D. Waco
of New Martinsville, W. Va. on the ~~Pearl~~ ^{of} ~~Baxter~~ ^{of} ~~heirs~~ Farm
Consisting of $88\frac{8}{10}$ Acres,
Located in Proctor District, Wetzel County.

WET-30
CANCELLED

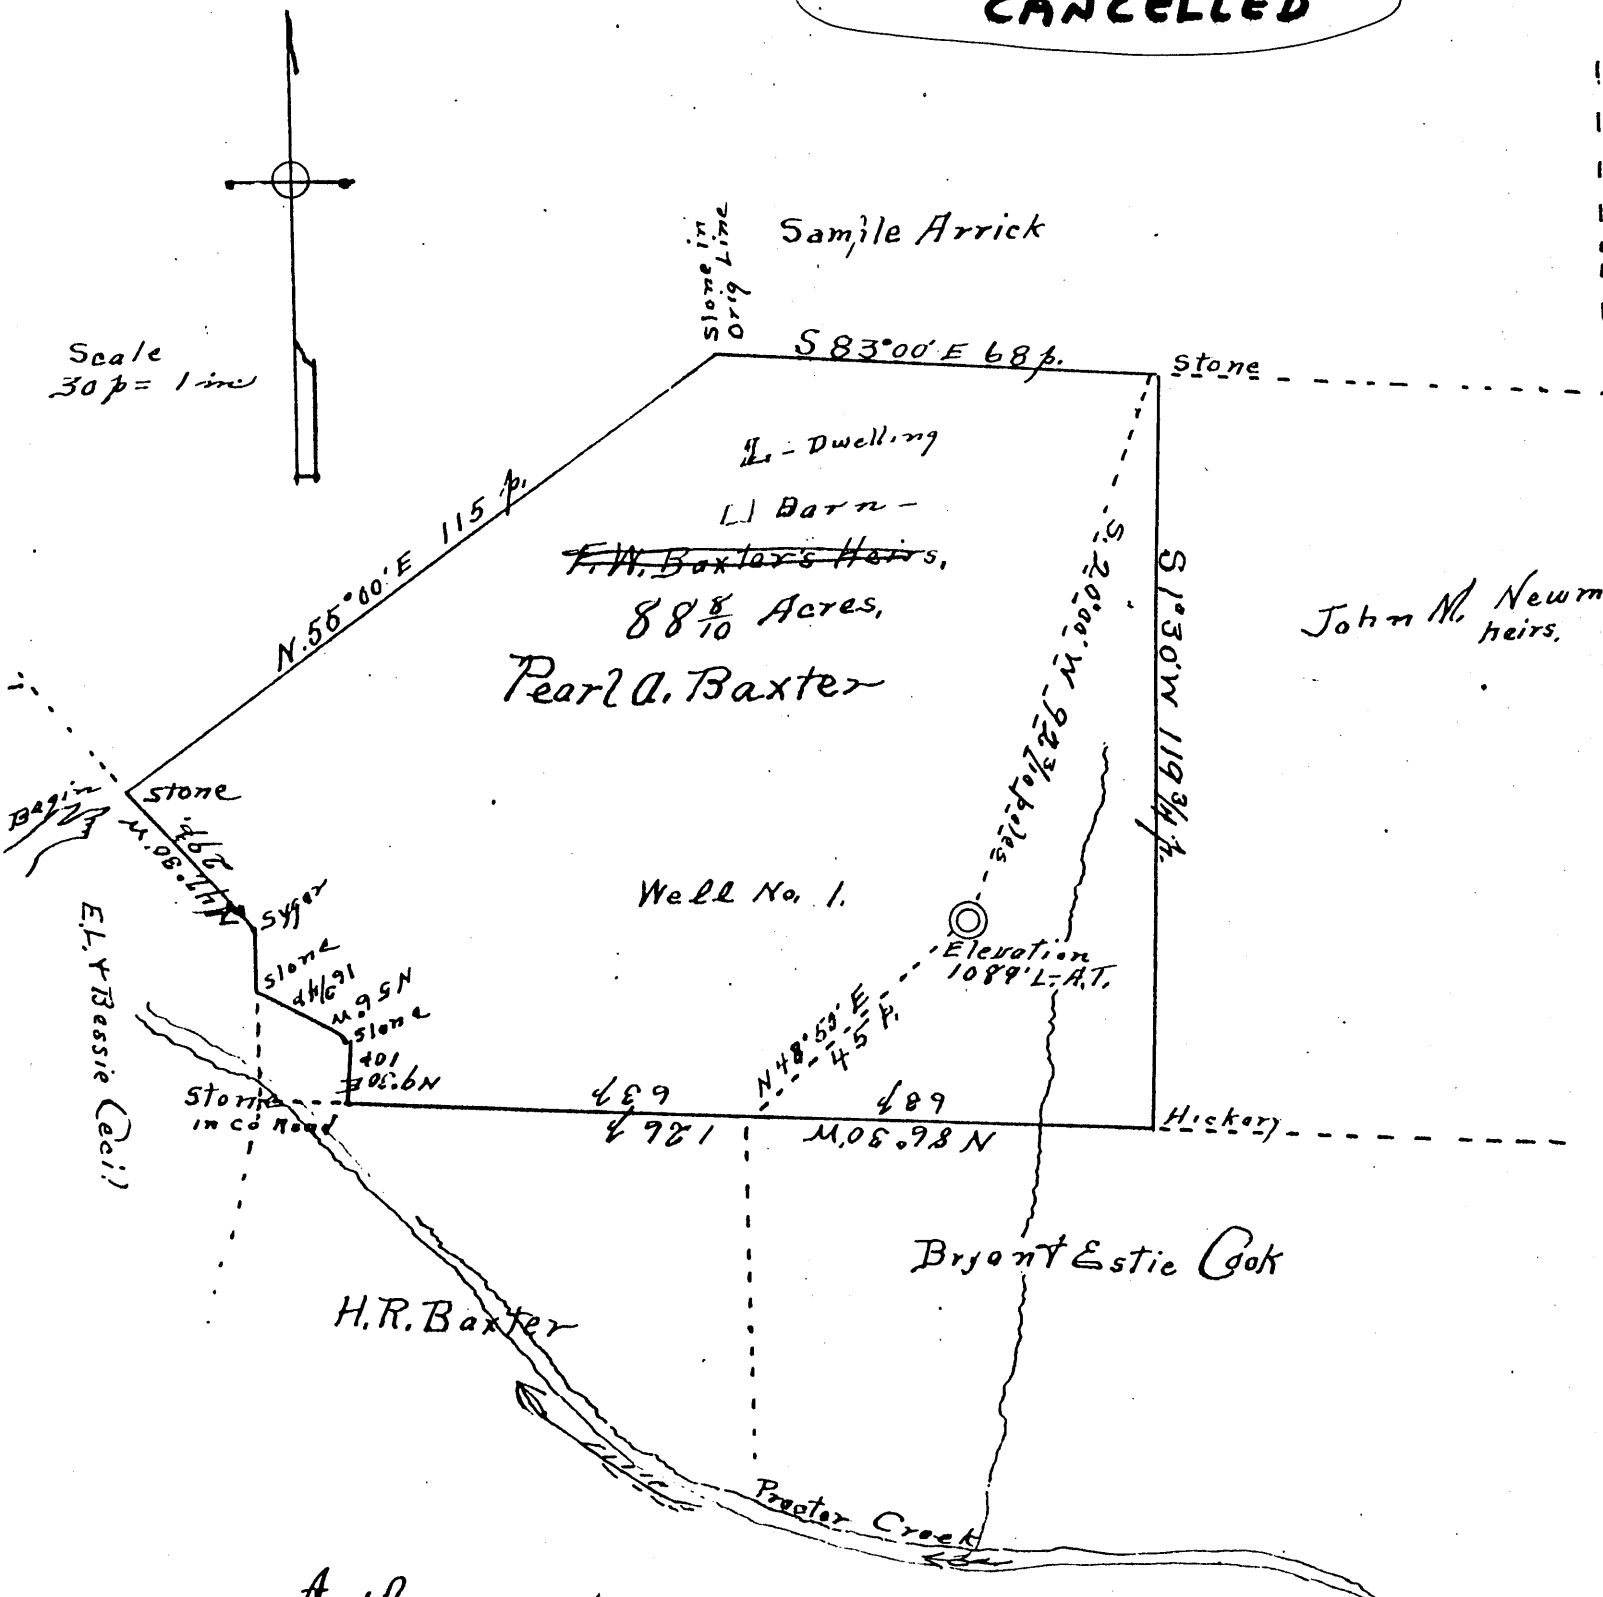

I, the undersigned, hereby certify that this
Map is correct and shows all the information
to the best of my knowledge and belief
required by the oil and gas section of
the Mining Law of West Virginia.
G.W. Parsons
Engineer.

Acknowledged before me a Notary Public
of Wetzel Co. West Virginia, this
8th day of April 1930
G.W. Coffield, Notary Public
My commission expires July 9 1930